

Name Jerry Gosley & Rustal Klein

Service No. 37

Address 29 Yina Street

39 Vine Street

Location

Kind of Pipe

Size 6"

Size of Mains 8"

Repair - Sewer - 200' of 6" Dia. V.O. #6467

Location SEP 25 1978


Date	Material	Amount	Total	Date	Amount
7/21-78	Labor	166.08		7-22-78	150.00
	10% O.H.	16.61	182.69	8-15-78	241.49
1	6" x 11 1/2" Bend		7.76		
1	3' x 6" Nipple		9.36	5-6-65	
1	4" x 6" Couplet		3.05	16-6-78	TRANSITS
2	yds. Loam @ 5.44		10.88		
5	lbs. Grass Seed @ 0.74		3.70		
2 1/2	hrs. Trucking @ 3.00		7.50		
2 1/2	hrs. Backhoe @ 6.50		16.25		
			241.19		
				7-18-78	Route 10-12'
				11-20-75	Route 10-12'

TOWN OF LEXINGTON — BOARD OF PUBLIC WORKS

SEWER DIVISION

DATE

Sketch of Service Here  
39

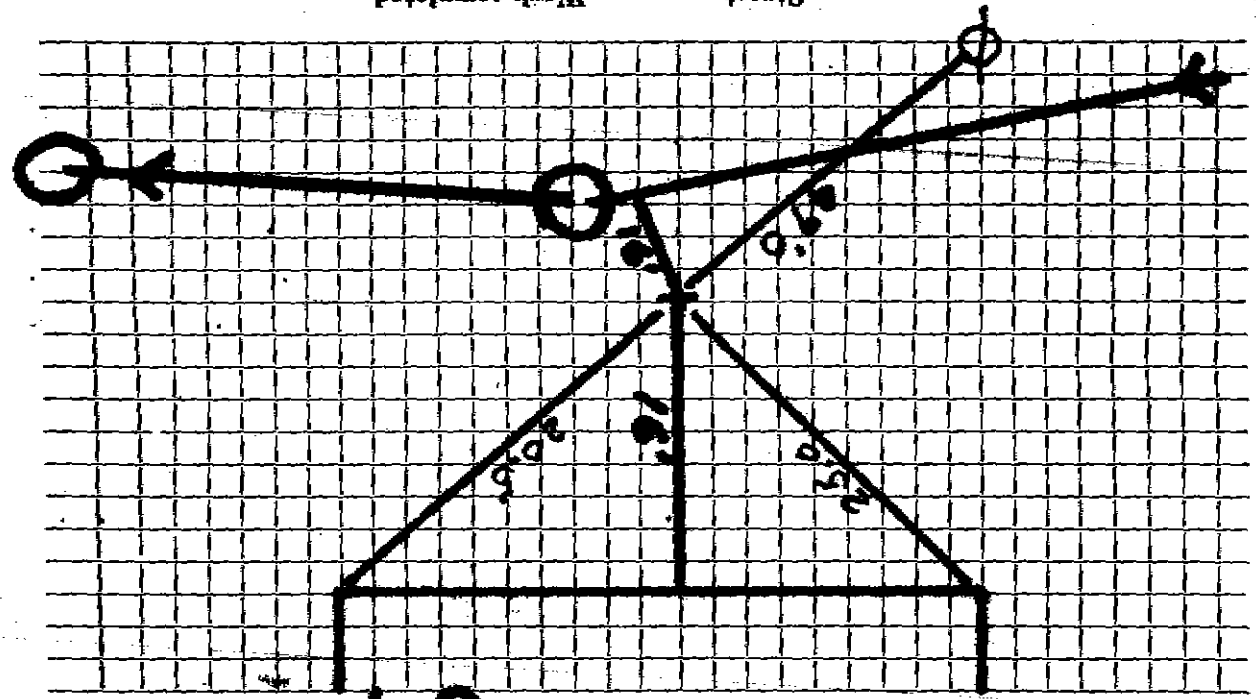

Street. Work completed

Connection made in  
Remarks: