

Name **Joseph Trippi**

Service No. **134**

Address **40** Vine Street

Lot ~~40~~ Vacant lot **40 Vine Street** Location

Kind of Pipe

Size **6"**

Size of Main **8"**

Repair—Renewal—New Service Trebino Const. Co. Permit #162


Location **MAR 14 1966**

Date	Material	Amount	Total	Date	Amount
6-65	14' 6" Transite pipe @ <del>2.00</del> 7.00		98.00	8-23-65	Deposit 98.00
3-65	16' Transite pipe @				

DATE \_\_\_\_\_

**TOWN OF LEXINGTON — BOARD OF PUBLIC WORKS**  
**SEWER DIVISION**

Sketch of Service Here **40**

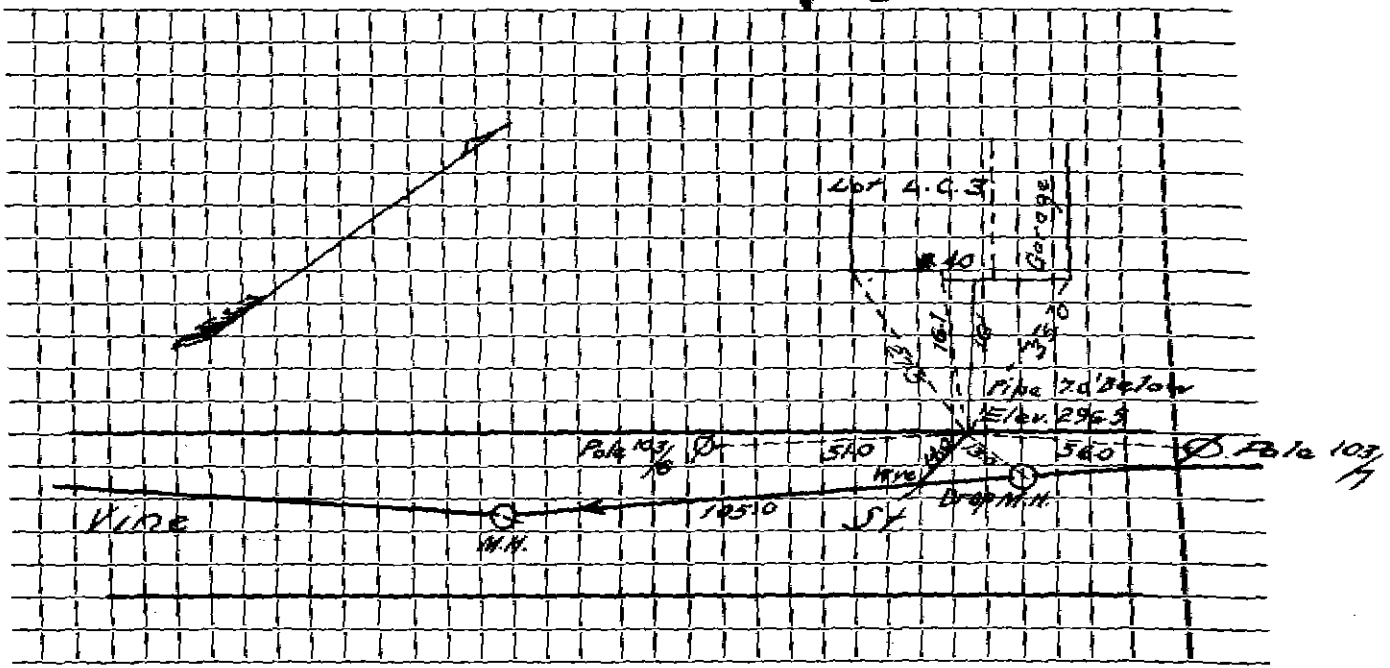

Connection made in ..... Street. Work completed .....

Remarks: .....  
.....  
.....