




DATE 9-19-2000

TOWN OF LEXINGTON — BOARD OF PUBLIC WORKS

SEWER DIVISION

Sketch of Service Here

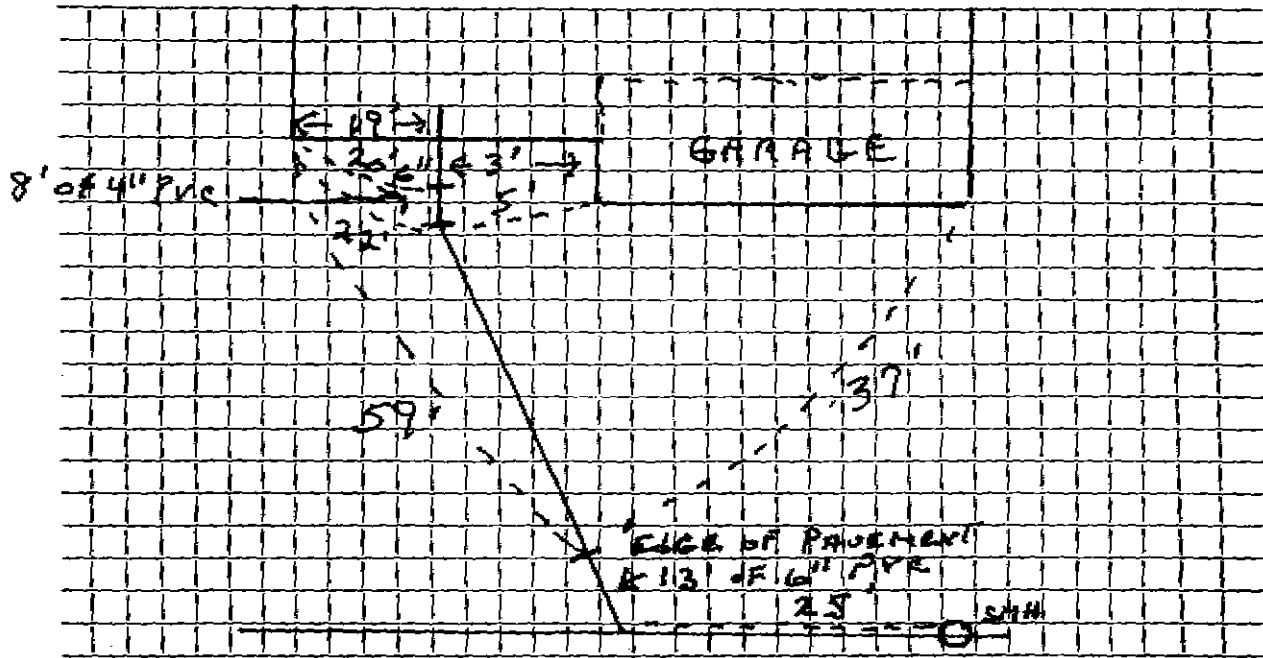

Connection made in VINE Street. Work completed

Remarks: INSTALLED BY J. McLAUGHLIN