


TOWN OF LEXINGTON — BOARD OF PUBLIC WORKS

SEWER DIVISION

DATE _____

Sketch of Service Here

67

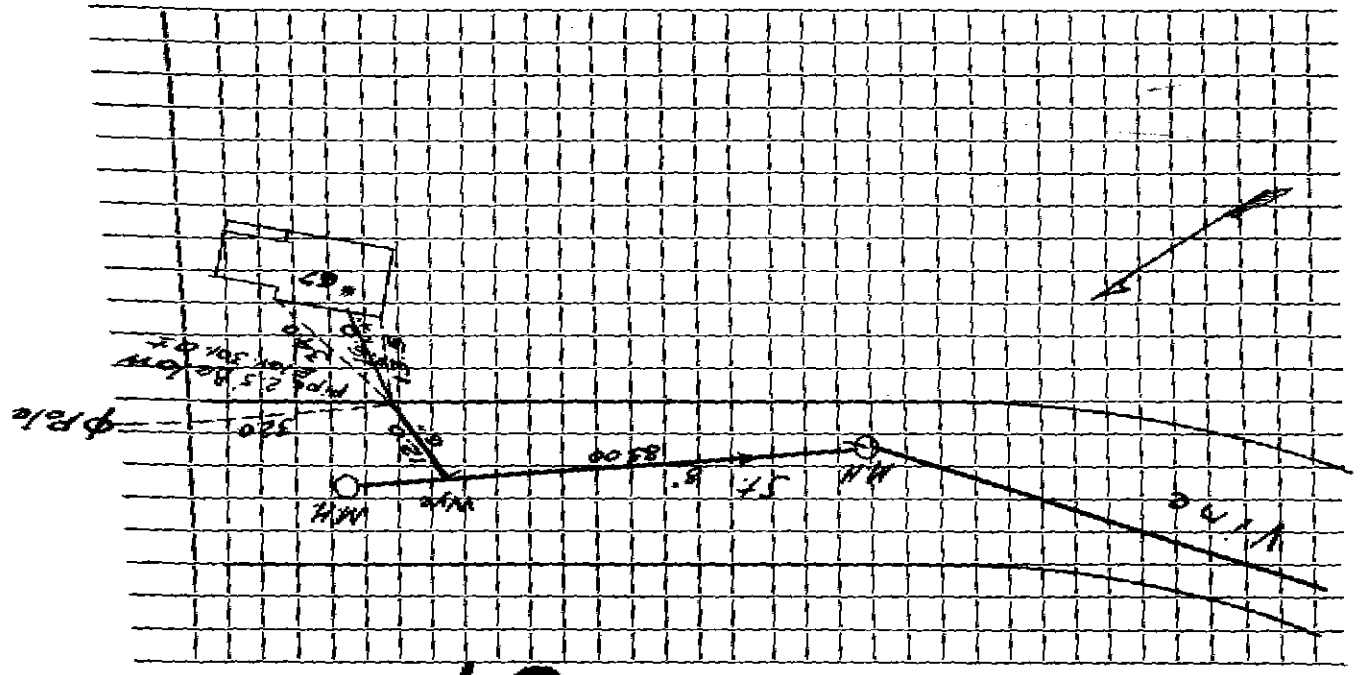

Work completed _____

Street _____

Connection made in _____

Remarks: _____