

Name Raymond Little

Service No. 53

Address 81 Vine Street

81 Vine Street

Location

Kind of Pipe

Size 6"

Size of Main 8"

Repair—Renewal—New Service Ferrari #1384 W.O. #6477

Location JUL 7 1969

Date	Material	Amount	Total	Date	Amount
6-13-69	Labor	49.63		6-16-69	100.00
	10% O.H.	4.97	54.60	7-7-69	2.97
18'	6" Transite pipe @.88		15.84		97.03
1	11 1/2" Transite Elbow		4.09		
3	hrs. Shovel @6.50		19.50		
1	hr. Trucking		3.00		
			97.03		
6-17-69	16' 6" Transite pipe				


DATE _____

TOWN OF LEXINGTON — BOARD OF PUBLIC WORKS

SEWER DIVISION

Sketch of Service Here

81

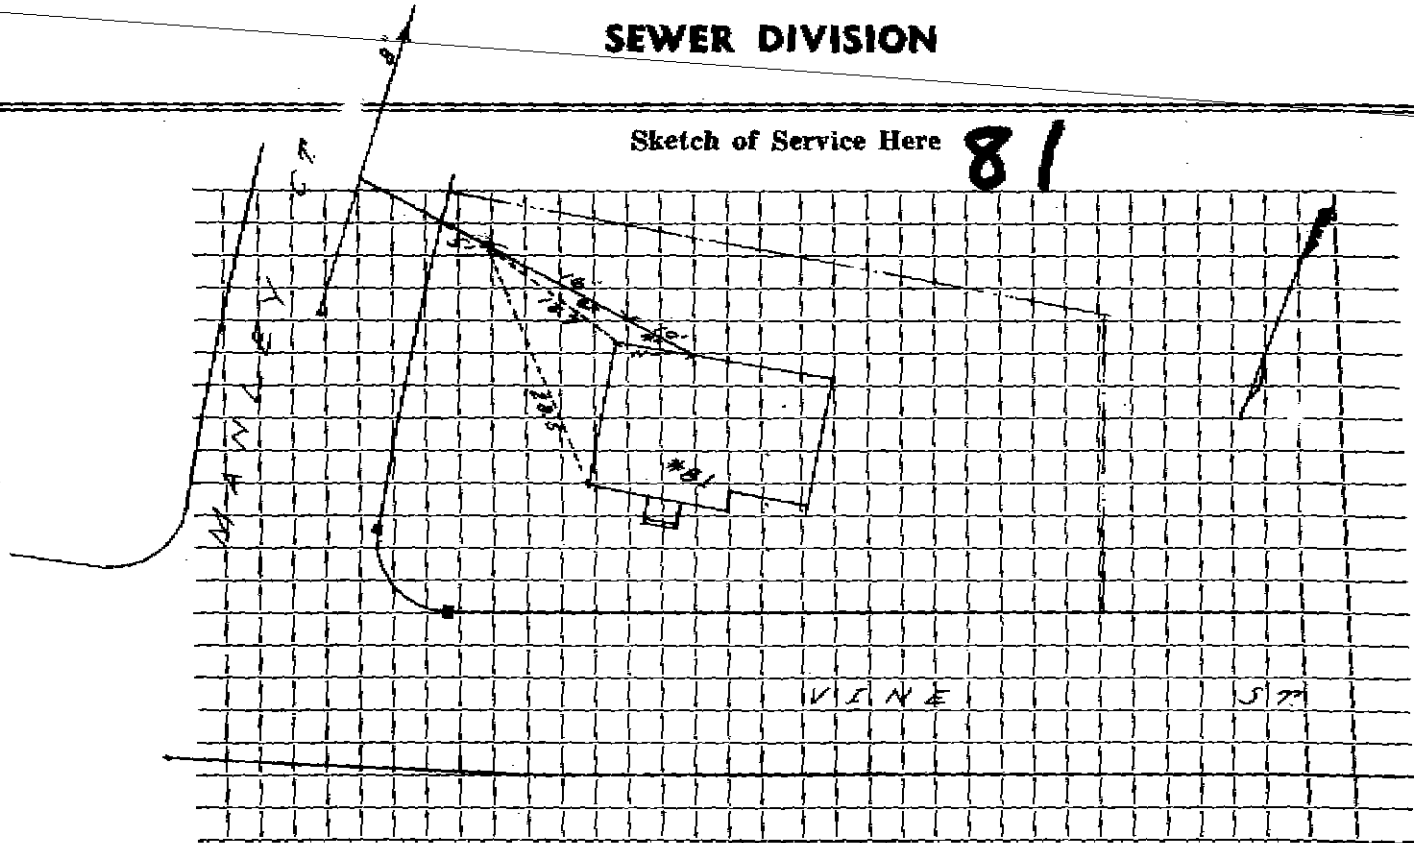

Connection made in Street. Work completed

Remarks:
.....
.....