


DATE 3-18-98

TOWN OF LEXINGTON — BOARD OF PUBLIC WORKS
SEWER DIVISION

Sketch of Service Here

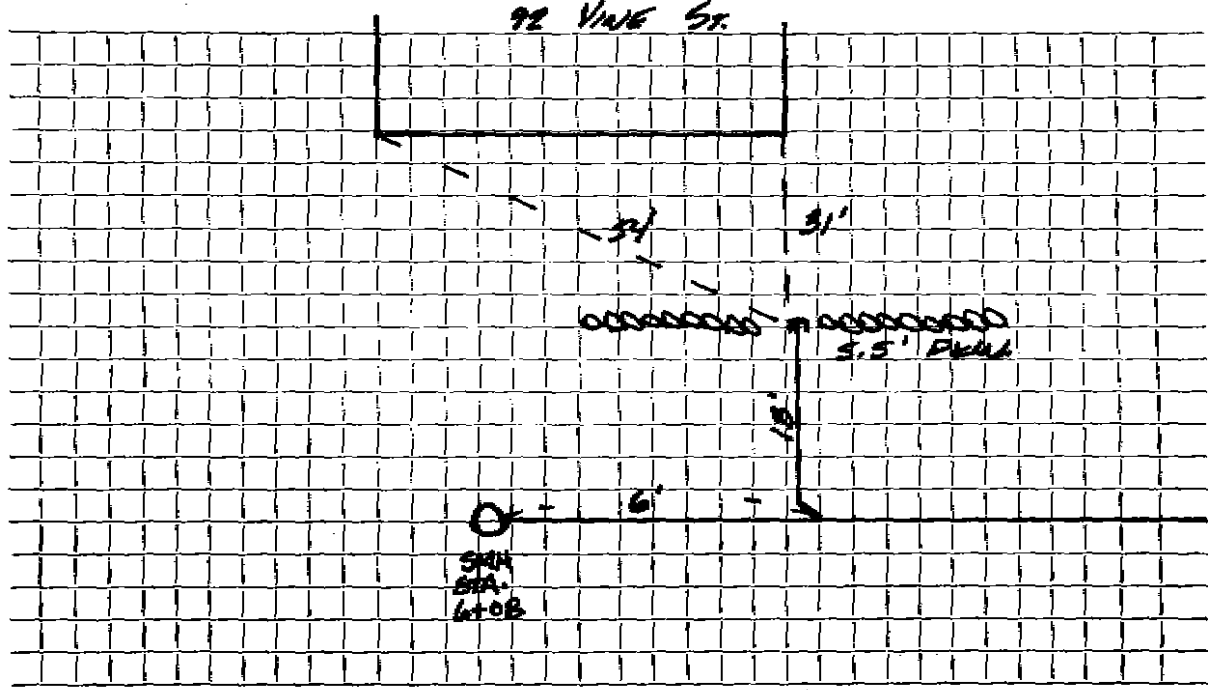

Connection made in VINE Street. Work completed CONTRACT 924

Remarks:

.....

.....