

Name Joan Moreau

Service No. 112

Address 93 Vine Street

93 Vine Street

Location

Kind of Pipe

Size 6"

Size of Main 8"

Repair—Renewal—New Service

Incidents #3140

Location NOV 19 1973


Date	Material	Amount	Total	Date	Amount
6/13/69	Labor	49.63		9-15-73	97.03
	10% O.H.	4.97	54.60		
18'	6" Transite pipe @.88		15.84		
1	11 1/2" Transite Elbow		4.09		
3	hrs. Shovel @6.50		19.50		
1	hr. Trucking		3.00		
			<u>97.03</u>		
10/12/73	85' 6" Transite pipe				

Deposit

97.03

TOWN OF LEXINGTON — BOARD OF PUBLIC WORKS

SEWER DIVISION

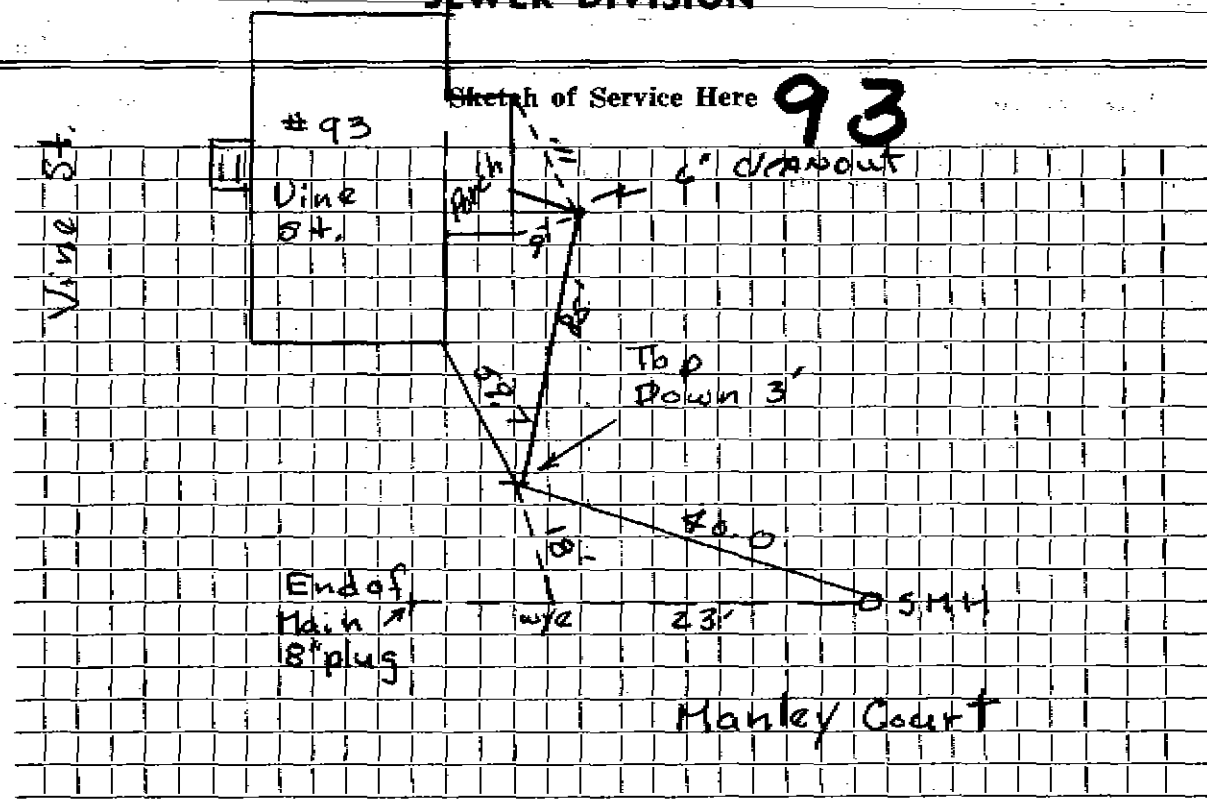

Connection made in ..... Street. Work completed .....

Remarks: Sewer connection made on Manley Court

.....  
.....