

Name

Contractor: Jim McLaughlin

Service No.

Address

17 Volunteer Way

Location

Kind of Pipe

SDR35 PVC

Size

6"

Size of Main

Repair

~~Renewal~~

New Service

Location

Date

Material

Amount

Total

Date

Amount

9/20/19

6" cleanout

6"-22° bend

6" SDR35 PVC 76'


6" fence to AC stub

length = 5.5'

DATE 9/20/19

TOWN OF LEXINGTON — BOARD OF PUBLIC WORKS
SEWER DIVISION

Sketch of Service Here

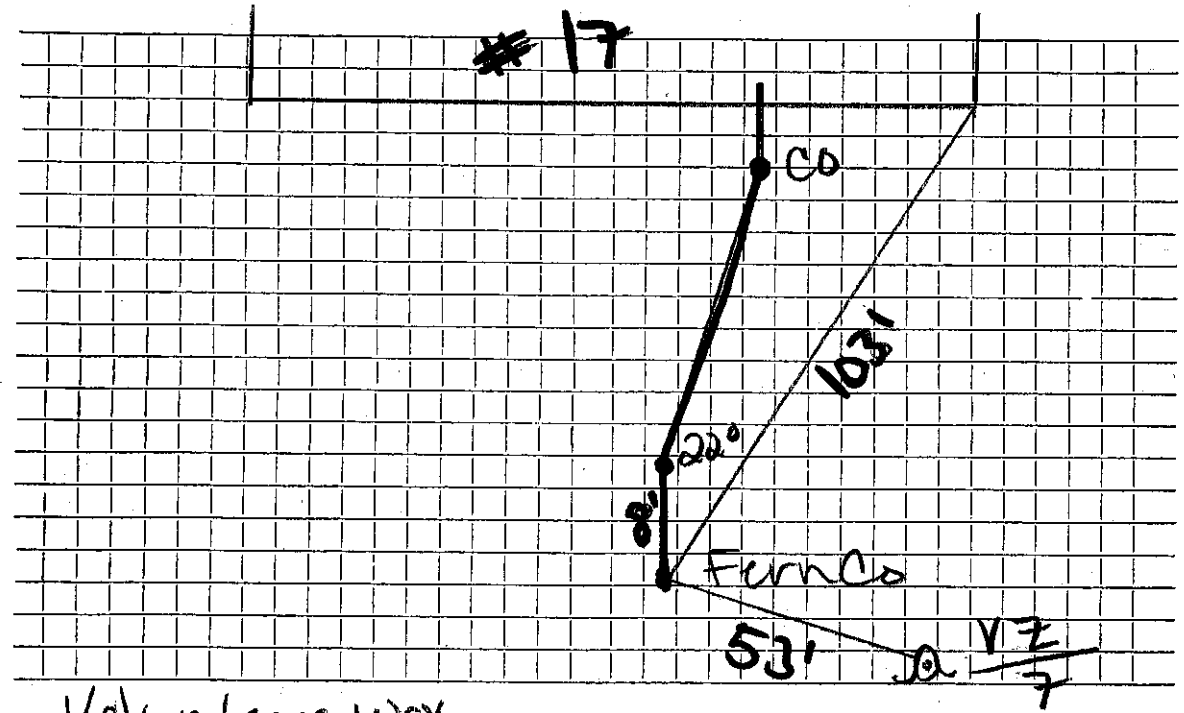

Connection made in ... Volunteer Way Street

Work completed

Remarks:
.....
.....