

Name

Service No.

Address

11 Volunteer Way

Location

Kind of Pipe

SDR Sch. 35 PVC Size 10"

Size of Main

Repair Renewal New Service

Location

Date

Material

Amount

Total

Date

Amount

5/20/21

4" Sch. 40 PVC

4x6" FernCo

6"-11° bend

6" tee wye

6" cleanout


6" Sch. 35 PVC

6"-22° bend

DATE 5/20/21

TOWN OF LEXINGTON — BOARD OF PUBLIC WORKS
SEWER DIVISION

Sketch of Service Here

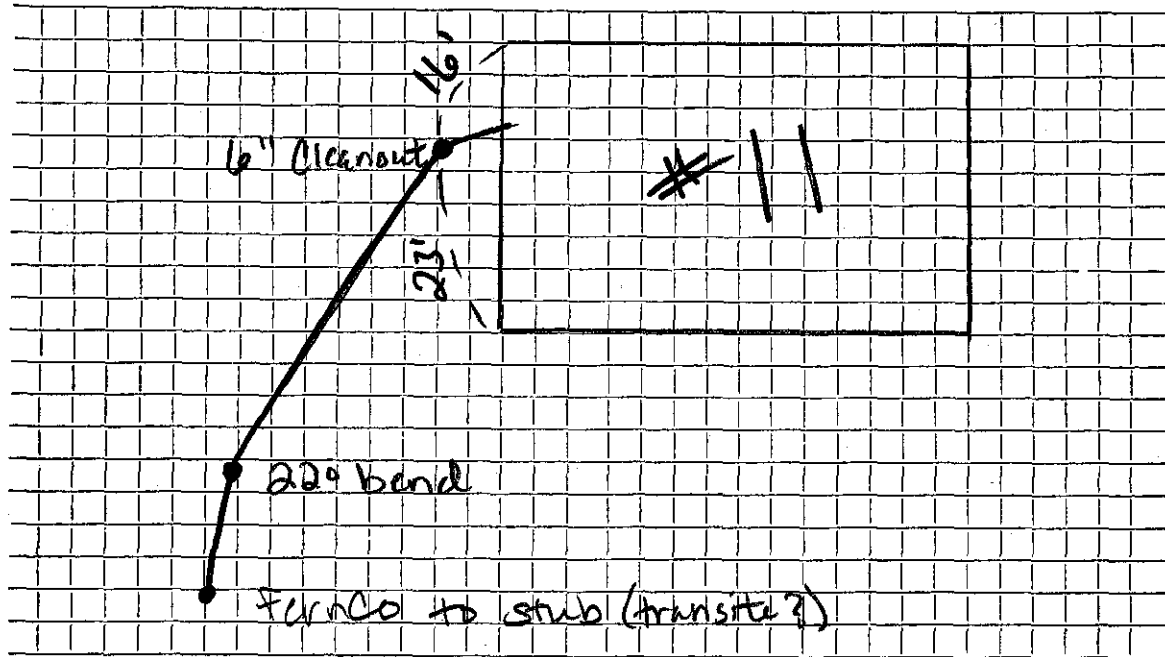

Connection made in Street. Work completed

Remarks:
@ cleanout: 11° bend, 6\" tee wye.
.....