

Name Contractor: CM Solutions

Service No.

Address 15 Volunteer Way

Location

Kind of Pipe 6" PVC SDR 35 Size

Size of Main

Repair ~~Renewal~~ New Service

Location

Date

Material

Amount

Total

Date

Amount

7/16/19

4" cleanout

6" PVC


11° bend

connected to  
existing

DATE 7/16/19

TOWN OF LEXINGTON — BOARD OF PUBLIC WORKS  
SEWER DIVISION

Sketch of Service Here

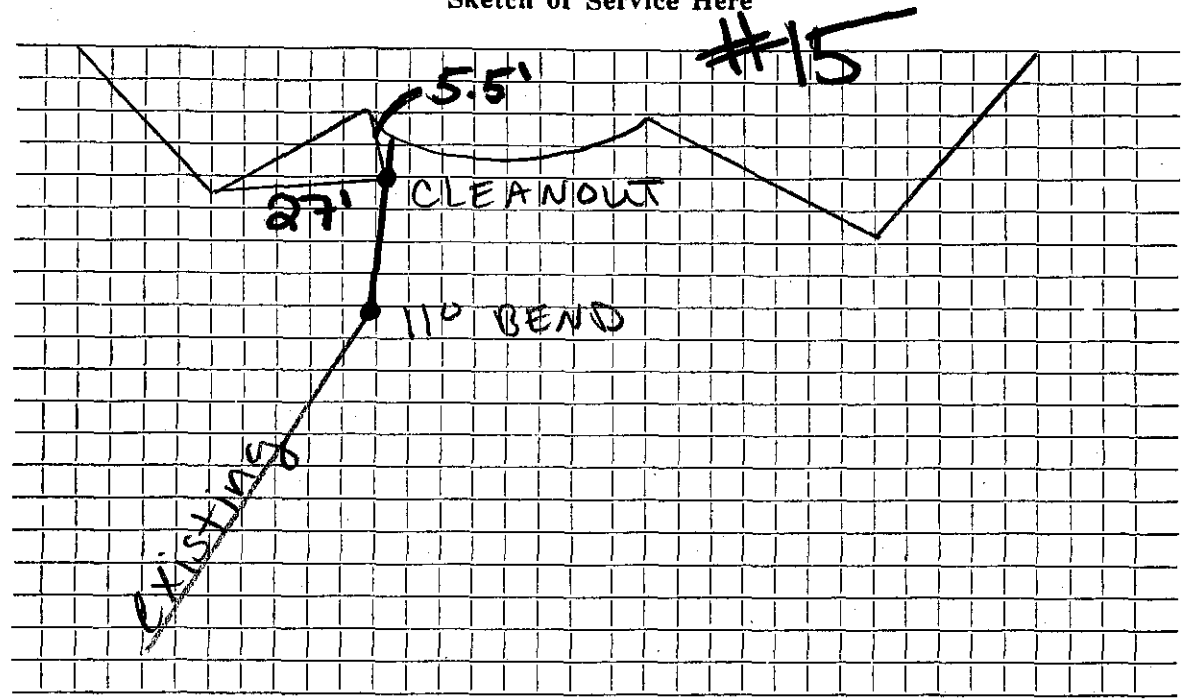

Connection made in Volunteer Way Street. Work completed .....

Remarks: .. Contractor had water crossing over sewer service .. near the house about 2" above. Made him bring it up another foot above to get more separation while still keeping 4' depth