


DATE

TOWN OF LEXINGTON — BOARD OF PUBLIC WORKS
SEWER DIVISION

Sketch of Service Here

17

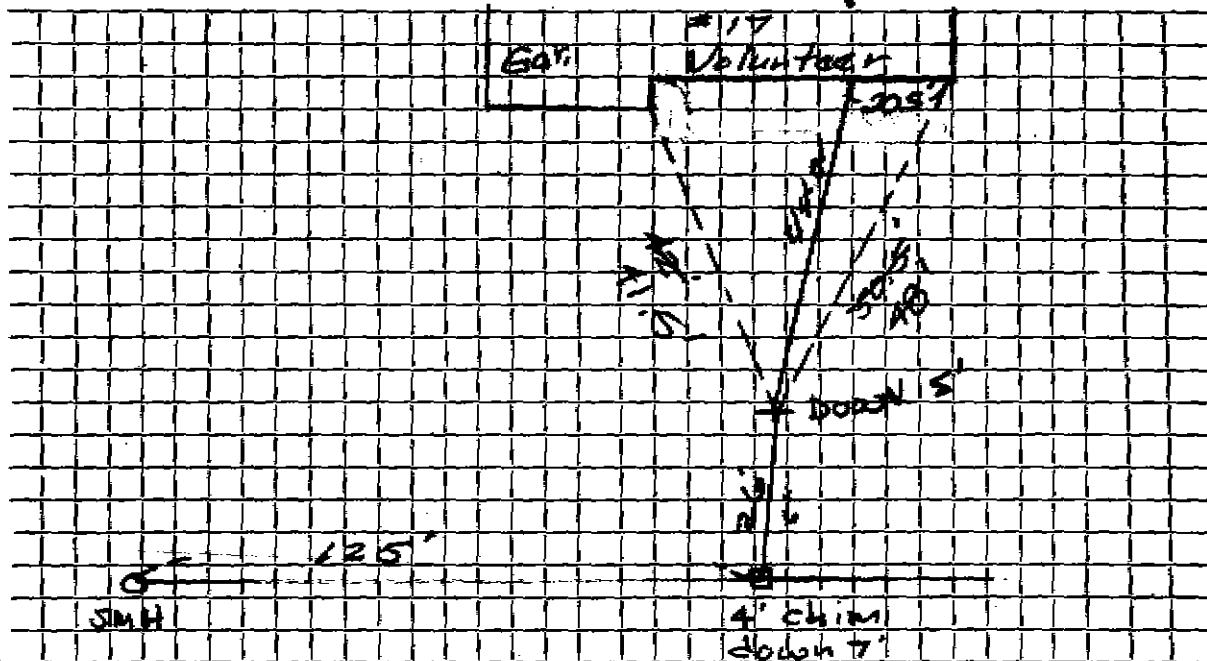

Connection made in Volunteer way..... Street. Work completed .. 12/18/75

Remarks: