

Name Woodhaven Realty

Service No.

Address #19 VOLUNTEER WAY

19 Volunteer Way

Location

Kind of Pipe PVC

Size 6"

Size of Main 8"

Repair—Renewal—New Service

McLaughlin #0025

Location

Date	Material	Amount	Total	Date	Amount
4/28/89	6" PVC	64'-6"		11-28-89	210.00
"	4" PVC	6"		Paid	
"	22" BEND	1			
"	6"x4" REDUCER (FERRO)	1			
"	1.5 STONE				
11/17/75	21' 6" A.A. @10.00		210.00		


DATE 11/28/89 (TUES.)

TOWN OF LEXINGTON — BOARD OF PUBLIC WORKS

SEWER DIVISION

Sketch of Service Here

19

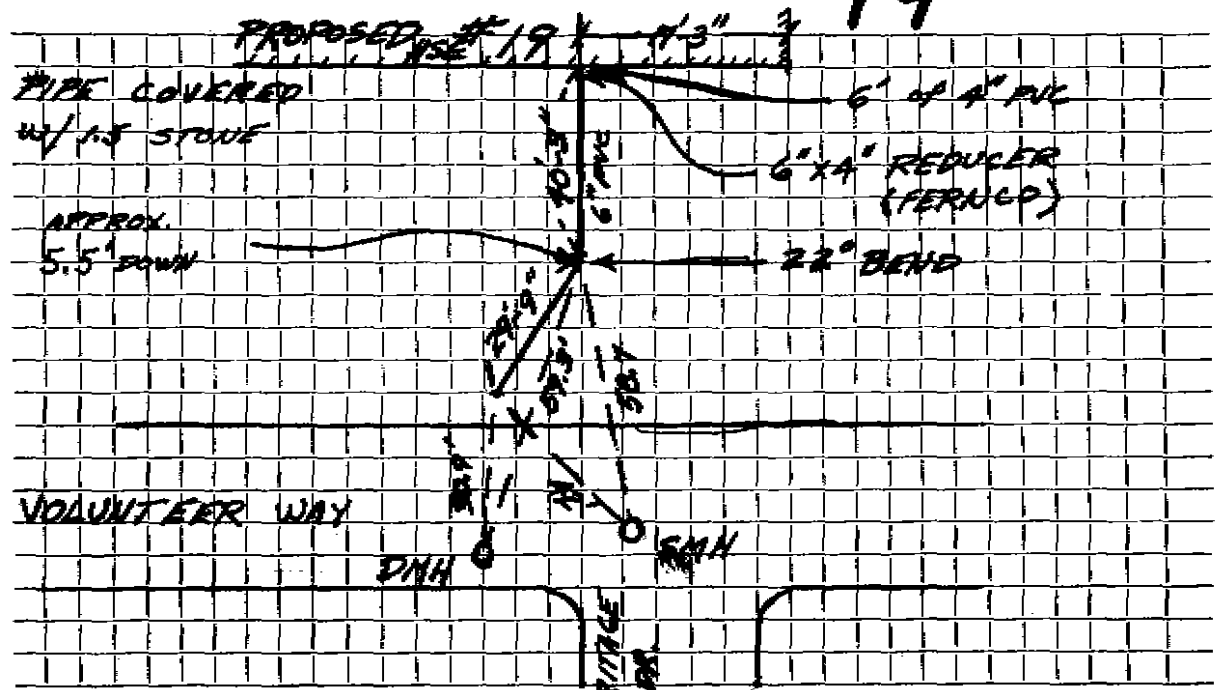

Connection made in VOLUNTEER WAY Street. Work completed

Remarks:

.....

.....