


DATE 5/13/92

TOWN OF LEXINGTON — BOARD OF PUBLIC WORKS
SEWER DIVISION

Sketch of Service Here **21**

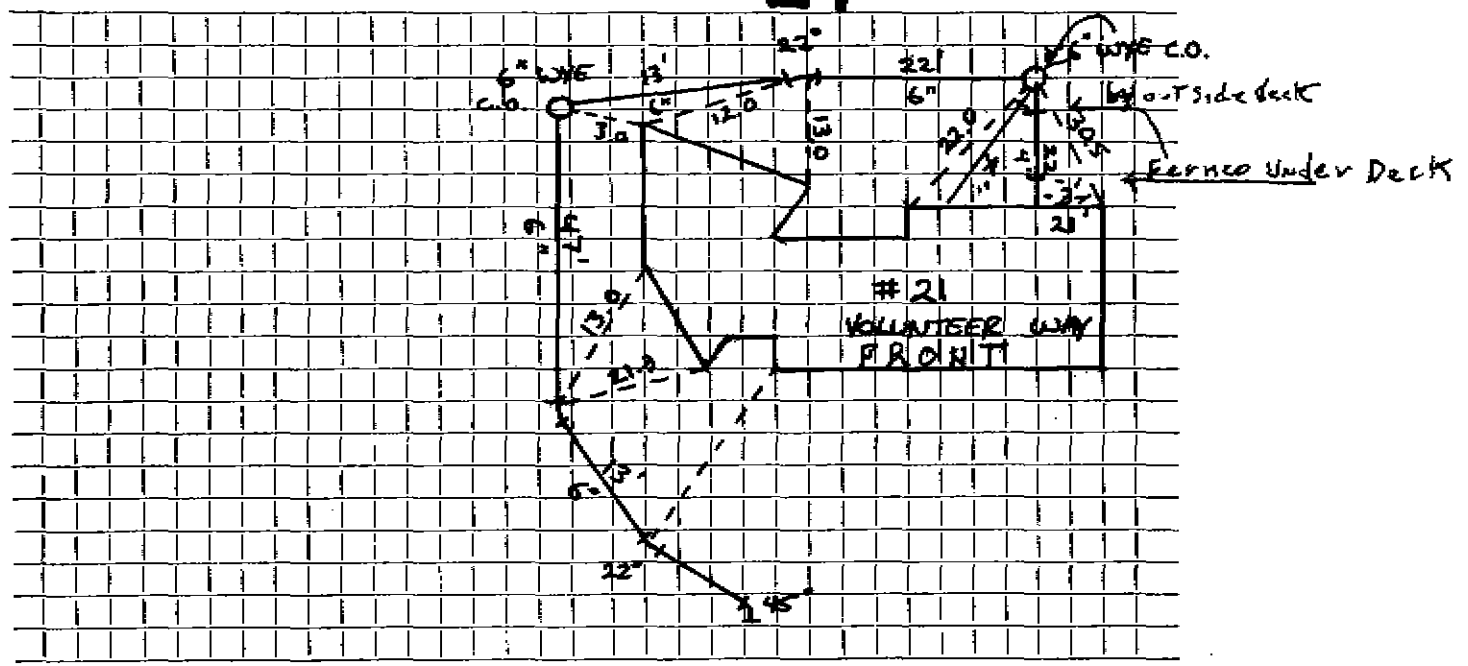

Connection made in Street. Work completed

Remarks: INSTALLED BY SUBURBANITE / Repair 3/21/09 - Larry Carroll J.B.

INSPECTED BY CRG