

Name

Service No.

Address

26 Volunteer Way

Location

Kind of Pipe

SDR Sch. 35 PVC

Size

6"

Size of Main

Repair

~~Renewal~~

New Service

Location

Date

Material

Amount

Total

Date

Amount

11/4/20

6" SDR 35 PVC

40'

4" SDR 40 PVC

10'

4" PVC cleanout


22° bend

8x6" tee wye

DATE 11/4/2020

TOWN OF LEXINGTON — BOARD OF PUBLIC WORKS
SEWER DIVISION

Sketch of Service Here

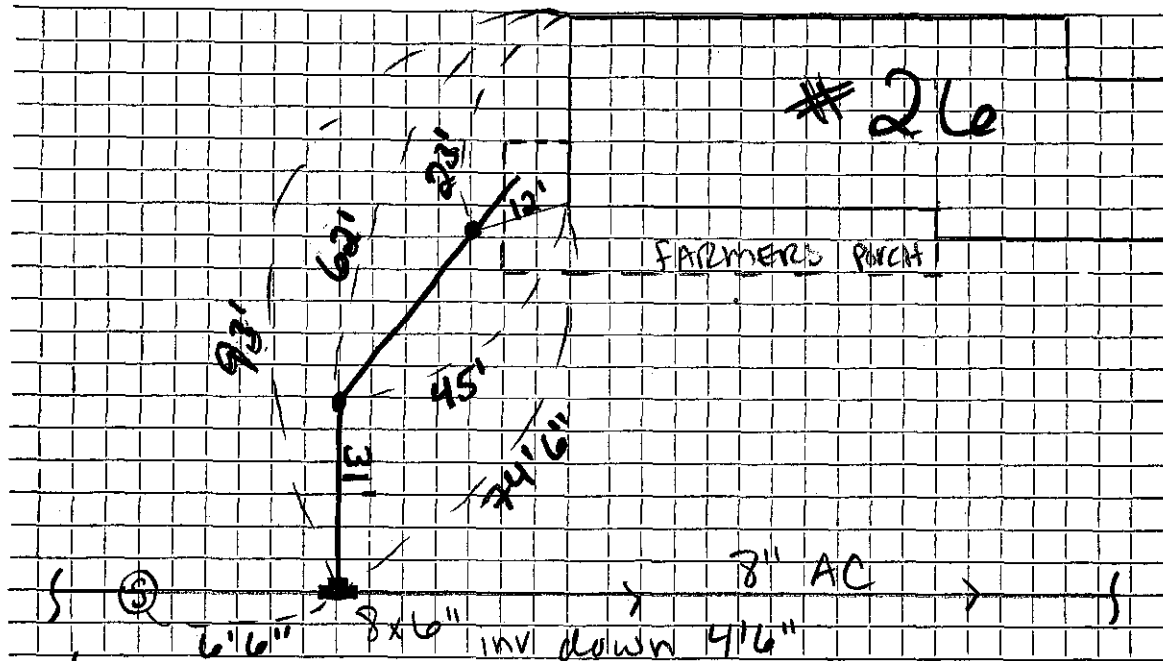

Connection made in Volunteer Way Street. Work completed

Remarks:

.....

.....