




TOWN OF LEXINGTON — BOARD OF PUBLIC WORKS

SEWER DIVISION

DATE

Sketch of Service Here

27

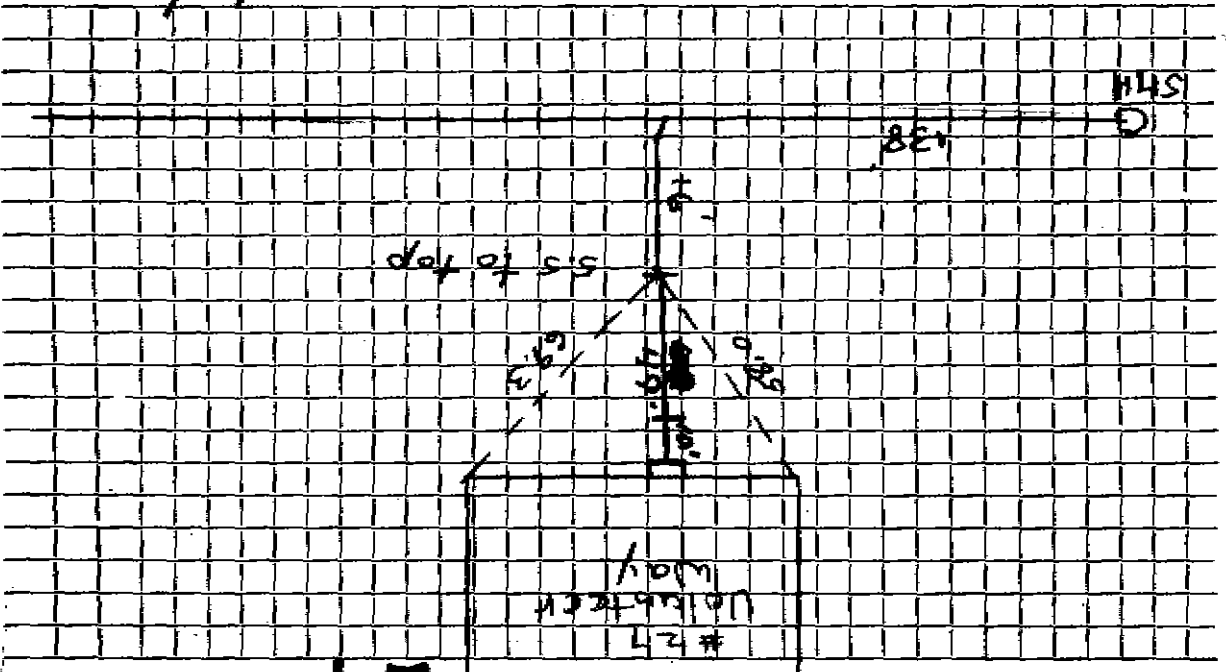

Connection made in

Wilmington

Street.

Work completed

9/30/75

Remarks: