


TOWN OF LEXINGTON — BOARD OF PUBLIC WORKS

SEWER DIVISION

DATE _____

Sketch of Service Here

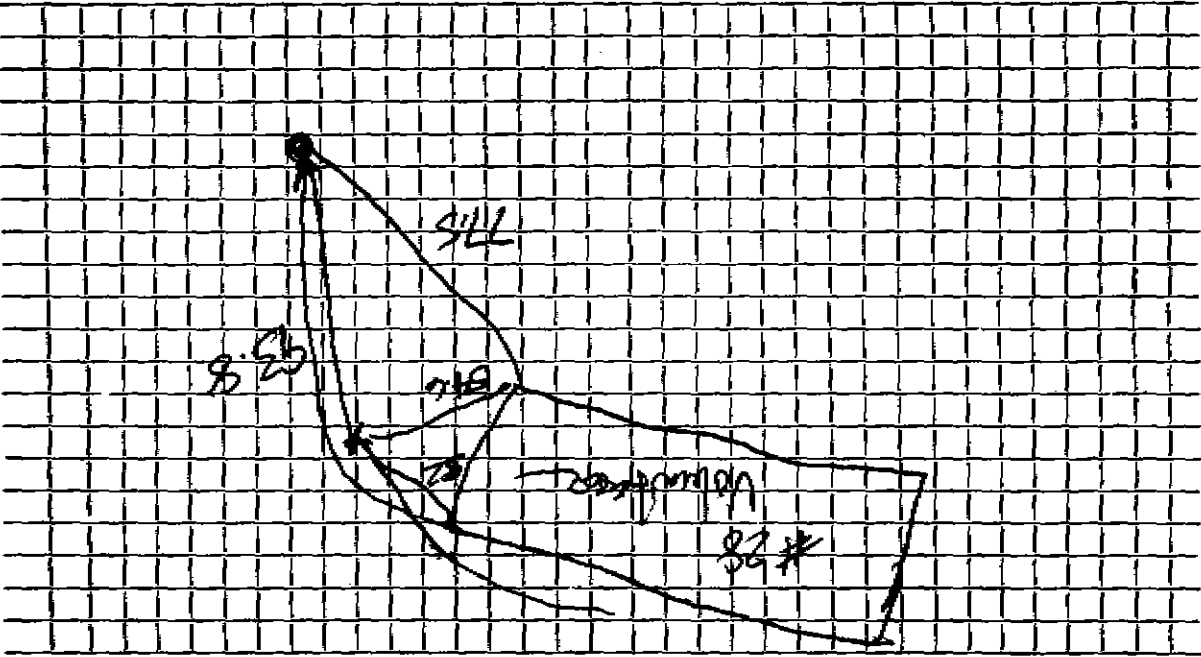

Work completed

Street.

Connection made in

Remarks:

Service goes out to basement