

Name Roger Trudeau

Service No. 40

Address 7 Volunteer Way

7 Volunteer Way

Location

Kind of Pipe AC

Size 6"

Size of Main 8"

Repair—Renewal—New Service

Valve # 2980

Location


OCT 25 1976

| Date | Material | Amount | Total | Date | Amount |
|--------|------------|-----------|----------|---------|---------|
| 9-9-75 | 27'-C'AC @ | \$10.00 = | \$270.00 | 4-14-76 | Deposit |
| | | | | | |
| | | | | | |
DATE _____

TOWN OF LEXINGTON — BOARD OF PUBLIC WORKS
SEWER DIVISION

Sketch of Service Here ?

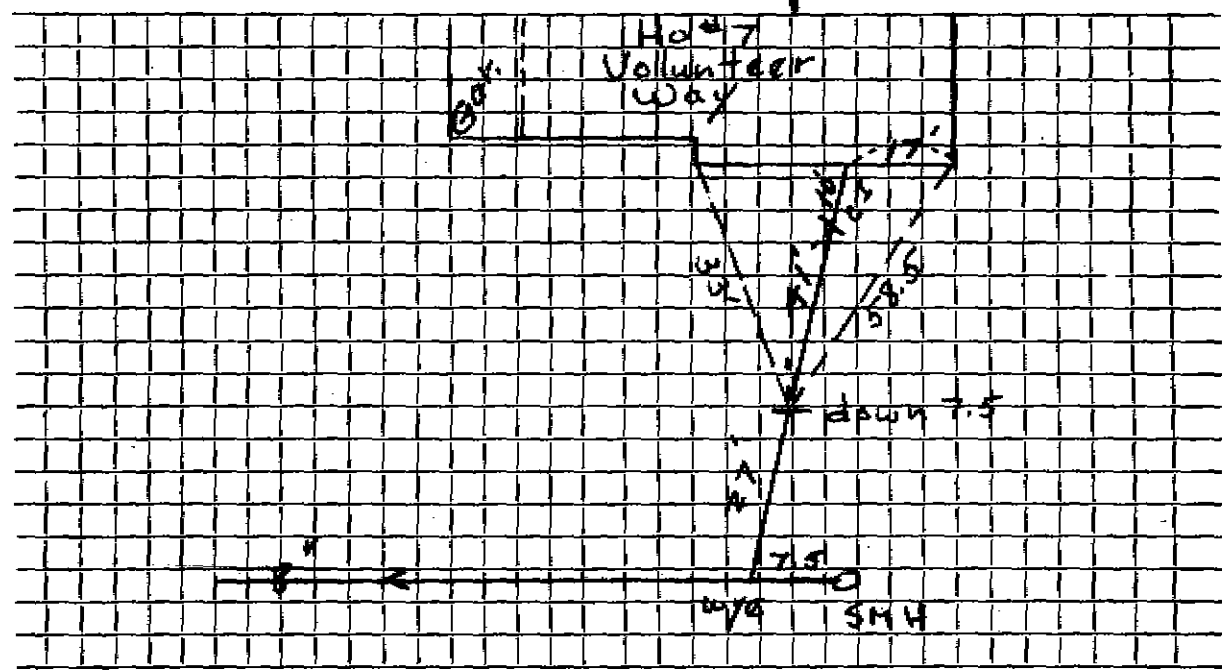

Connection made in Volunteer way Street. Work completed

Remarks: