

Review Lessons III

Service No. 82

8 Volumetric Way
Aug 1997
Location JUN 20 1997

Kind of Pipe A	Size 6"	Size of Main 8"
----------------	---------	-----------------

New Service

Lex. Severage #2873

Section

Remarks:


Connection made in

Volunt

er Way

Street

Work completed

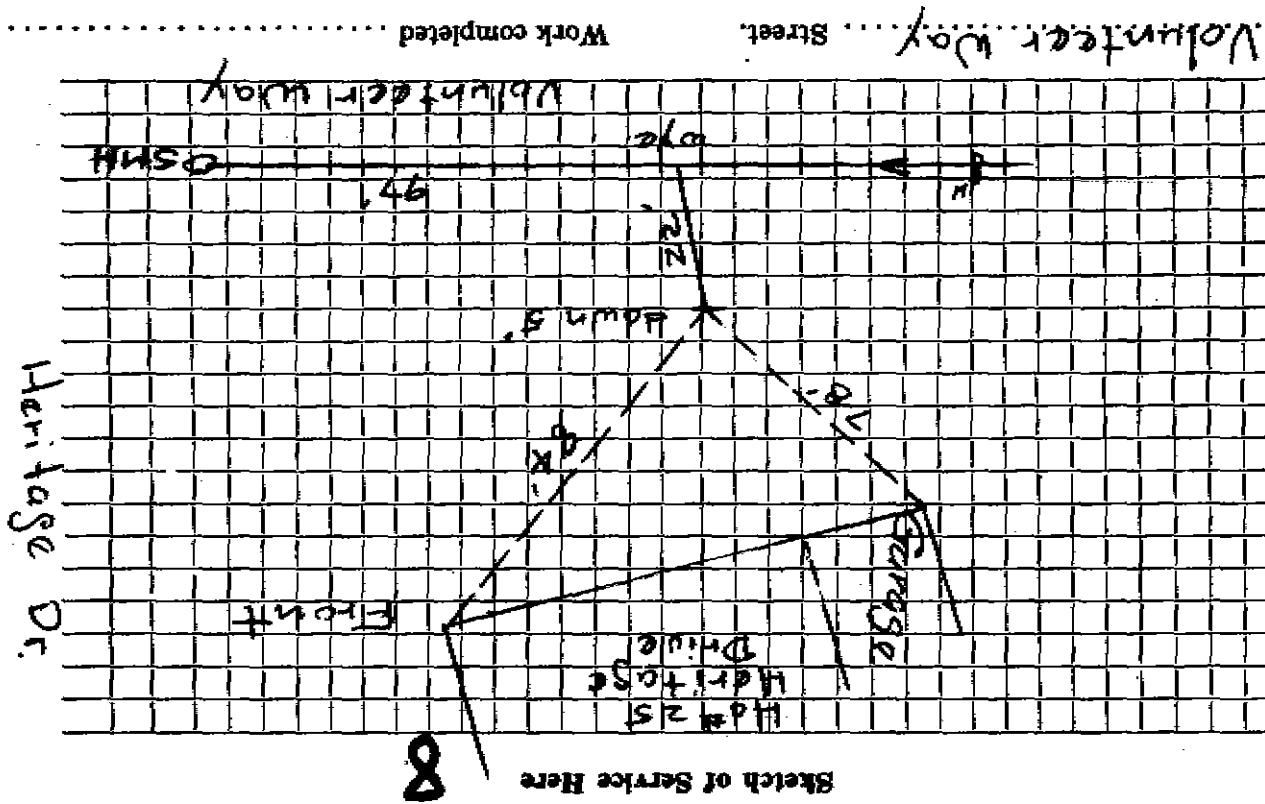

SEWER DIVISION

TOWN OF LEXINGTON — BOARD OF PUBLIC WORKS

DATE