


DATE 9.17.96

TOWN OF LEXINGTON — BOARD OF PUBLIC WORKS
SEWER DIVISION

Sketch of Service Here 9

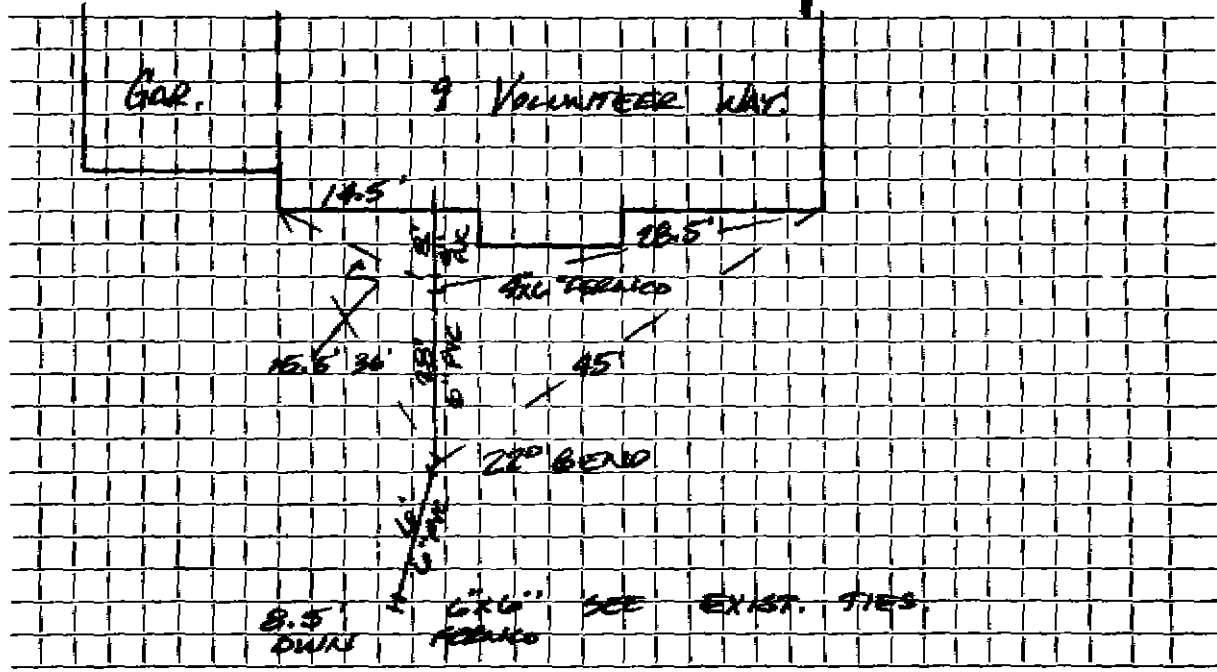

Connection made in VOLUNTEER Street. Work completed KIRKLAND & SHAW.

Remarks: THIS A DRY HOOD UP, BROUGHT INTO HOUSE AND
CAPPED.

BOOK 96-4