

Name **Win. S. Couette**

Service No. **56**

Address **Wachusett Circle**

Lexington 4 Wachusett's Circle Location

Kind of Pipe

Size **6"**

Size of Main **8"**

~~XXXXXXXXXX~~ **New Service** COM. **5-18-53**

Location

Date	Material	Amount	Total	Date	Amount
1/22/53	Labor	54 17		4-3-53	Deposited 150 00
	10% overhead	5 42	59 59	5-18-53	Refunded (9 03)
	60' - 5" Transite Pipe @.55		33 00		140 97
	1-6" Elbow		1 88		
	6 Hr. Littlefield Shovel @7.50		45 00		
	2 Hr. Trucking		1 50		
			<u>140 97</u>		
	Labor				

TOWN OF LEXINGTON—DEPT. OF PUBLIC WORKS
SEWER DIVISION

DATE.....

NO.


The undersigned applies for the construction of a particular sewer connecting No.....
Street and hereby agrees to comply with the Rules and Regulations governing the construction and use of Particular
Sewers, as now or at any future time established by the Board of Selectmen.

Am't of estimate \$.....

Am't Paid \$.....

..... Owner

Sketch of Service Here

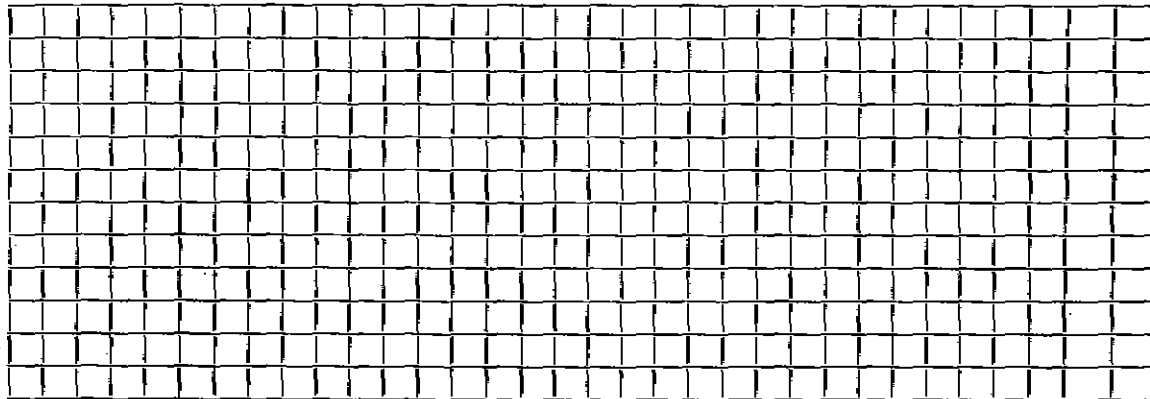

Connection made in..... Street.

Work completed.....19..

Remarks: