


DATE 6/21/95

TOWN OF LEXINGTON — BOARD OF PUBLIC WORKS

SEWER DIVISION

Sketch of Service Here

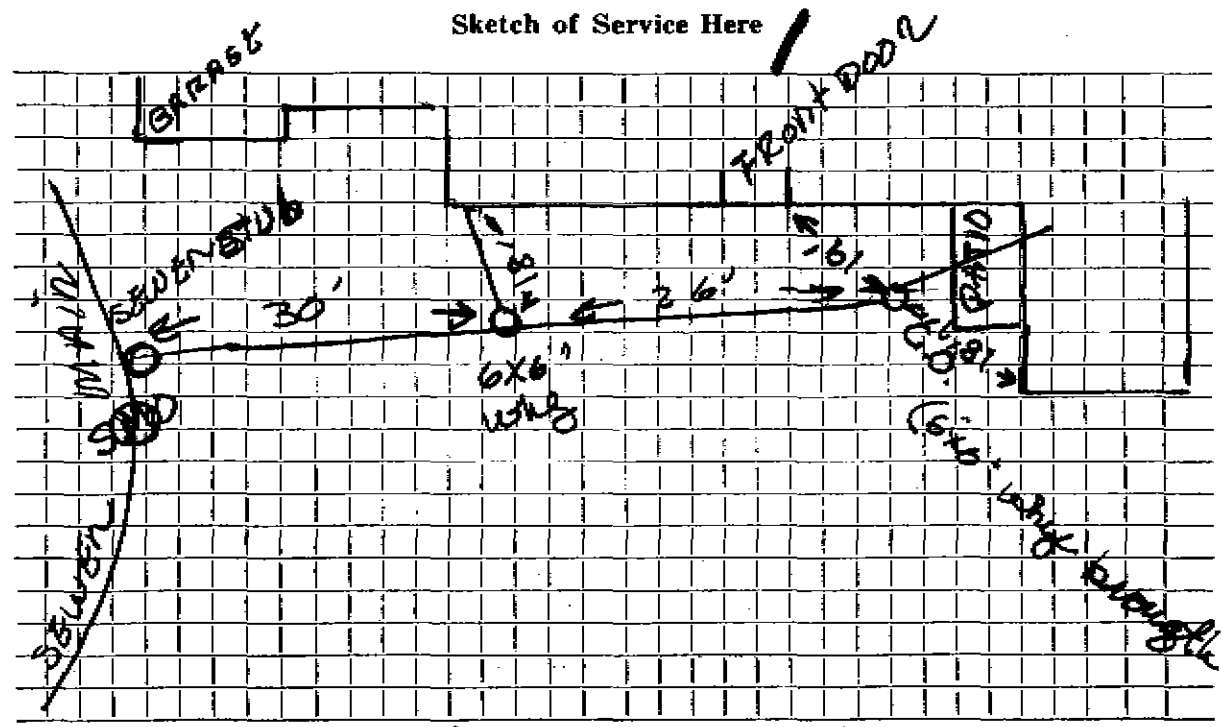

Connection made in WACHUSETT DRIVE Street.

Work completed

Remarks:

.....