


DATE _____

TOWN OF LEXINGTON — BOARD OF PUBLIC WORKS
SEWER DIVISION

Sketch of Service Here

19

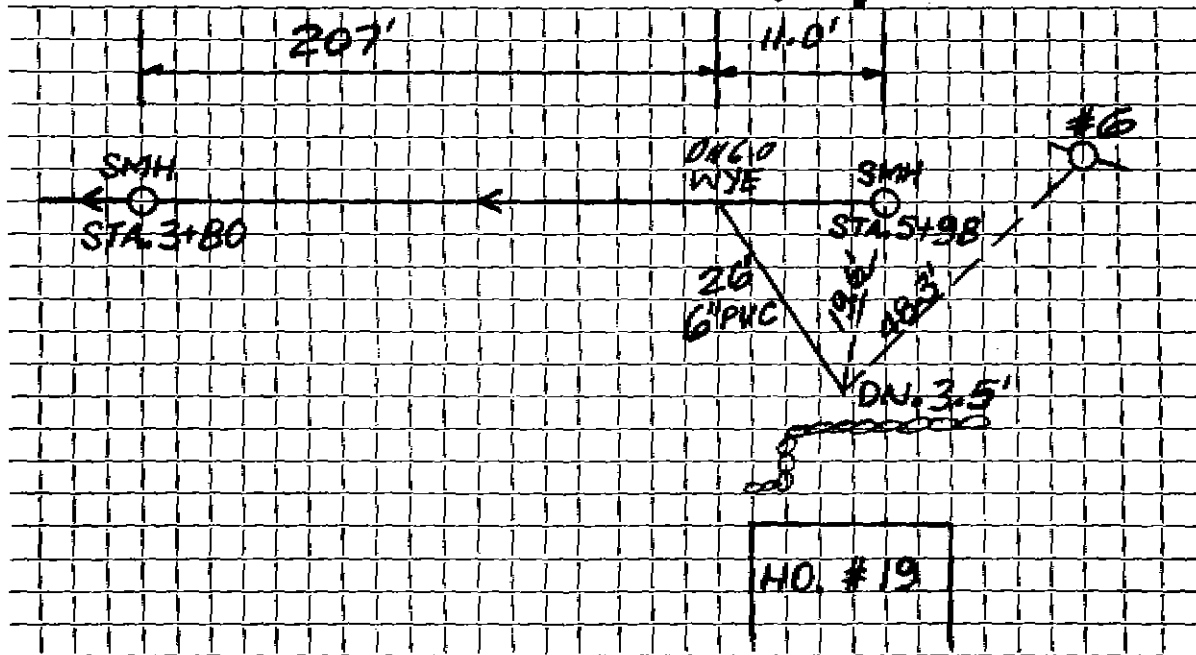

Connection made in WACHUSETT DRIVE Street.

Work completed

Remarks:

.....

.....