

Name Lester A. L. Olson

Service No. 23

Address 21 Wachusett Drive

21 Wachusett Drive

Location

Kind of Pipe

Size 6"

Size of Main 8"

~~REPAIR WORK~~ New Service

Com. 7-18-55

Location

Date	Material	Amount	Total	Date	Amount
5/13/55	Labor	36 37		9-29-55	Deposited 175 00
	10% overhead	3 64	40 01	7-18-55	Refunded (69 47)
	54' - 6" sewer pipe @ .32		17 28		105 53
	joint compound		3 24		
	5 hrs. Littlefield shovel @ 7.50		37 50		
	2 hrs. trucking @ .75		1 50		
	patching 6 x 3		6 00		
			105 53		
	Labor				

**TOWN OF LEXINGTON—DEPT. OF PUBLIC WORKS
SEWER DIVISION**

DATE

NO.


The undersigned applies for the construction of a particular sewer connecting No.
Street and hereby agrees to comply with the Rules and Regulations governing the construction and use of Particular
Sewers, as now or at any future time established by the Board of Selectmen.

Am't of estimate \$.....

Am't Paid \$.....

..... Owner

Sketch of Service Here

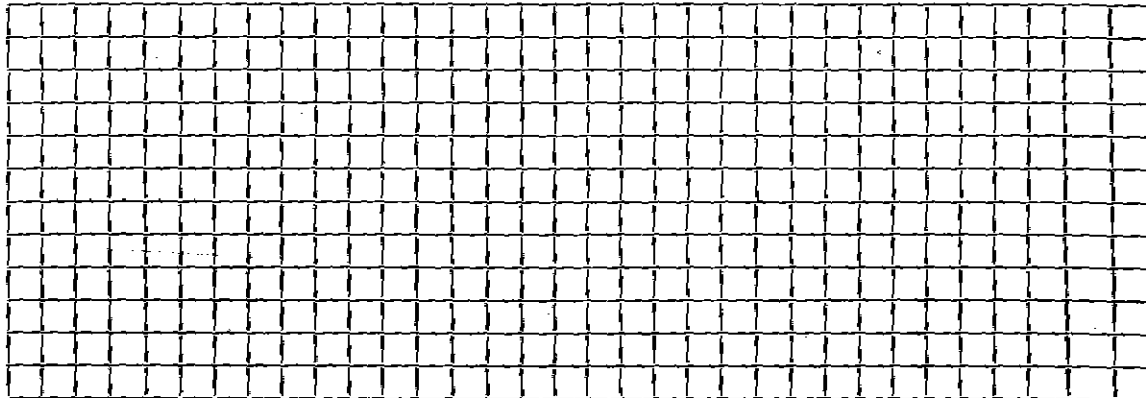

Connection made in

Street.

Work completed

19..

Remarks: