

Name Mr. George E. Ellard

Service No. 70

Address 25 Wachusetta Drive

25 Wachusetta Drive

Location

Kind of Pipe

Size 6"

Size of Main 8"

~~Repair~~ New Service

Location Comm 11-10-58

Date	Material	Amount	Total	Date	Amount
6-9-58	Labor	76.32		5-5-58	Deposit 150.00
	10% D.H.	7.63	83.95	11-10-58	Refund 85
	46' 6" Transite Pipe @.70		32.20		149.15
	3 hrs. Town Shovel @ 6.50		19.50		
	2 hrs. Trucking @.75		1.50		
	1 hr. Rodgers Trailer @3.00		3.00		
	1 hr. Trucking @3.00		3.00		
	6 x 3 Patch		6.00		
			149.15		
	Labor				

TOWN OF LEXINGTON—DEPT. OF PUBLIC WORKS
SEWER DIVISION

DATE.....

NO.....


The undersigned applies for the construction of a particular sewer connecting No.....
Street and hereby agrees to comply with the Rules and Regulations governing the construction and use of Particular
Sewers, as now or at any future time established by the Board of Selectmen.

Am't of estimate \$.....

Am't Paid \$.....

..... Owner

Sketch of Service Here

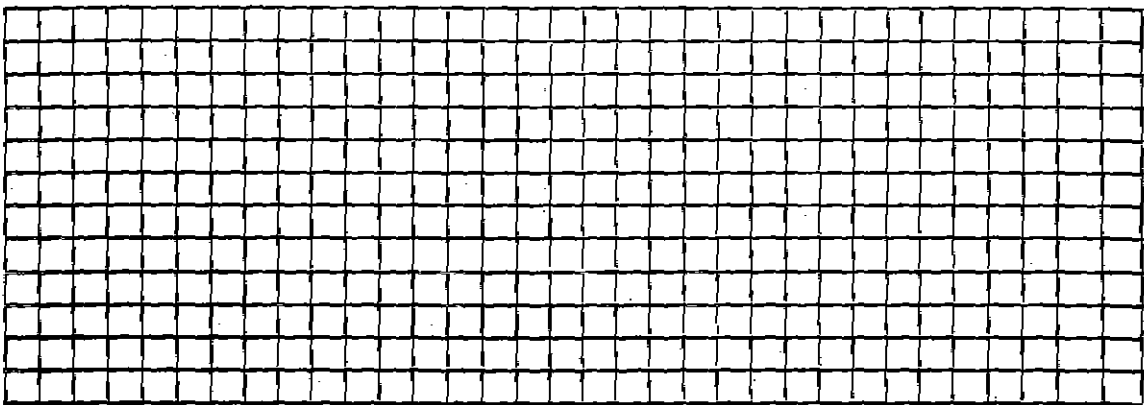

Connection made in..... Street.

Work completed.....19..

Remarks: