

Name George A. Mallion

Service No. 2

Address 29 Wachusetts Drive

29 Wachusetts Drive

Location

Comm. 6-2-58

Kind of Pipe

Size 6"

Size of Main 8"

~~Repair~~—Renewal—New Service

Location

Date	Material	Amount	Total	Date	Amount
3/25/58	Labor	76 69		1-8-58	Deposit
	10% overhead	7 67	84 36	6-2-58	Refund
	50' - 6" Transite Pipe @ .70		35 00		
	1 - 6" Clay Elbow		1 88		
	6x3 Patch		6 00		
	3 hrs. Town Shovel @ 6.50		19 50		
	2 hrs. Trucking @ .75		1 50		
			148 24		
	Labor				

**TOWN OF LEXINGTON—DEPT. OF PUBLIC WORKS
SEWER DIVISION**

DATE.....

NO.


The undersigned applies for the construction of a particular sewer connecting No.....
Street and hereby agrees to comply with the Rules and Regulations governing the construction and use of Particular
Sewers, as now or at any future time established by the Board of Selectmen.

Am't of estimate \$.....

Am't Paid \$.....

..... Owner

Sketch of Service Here

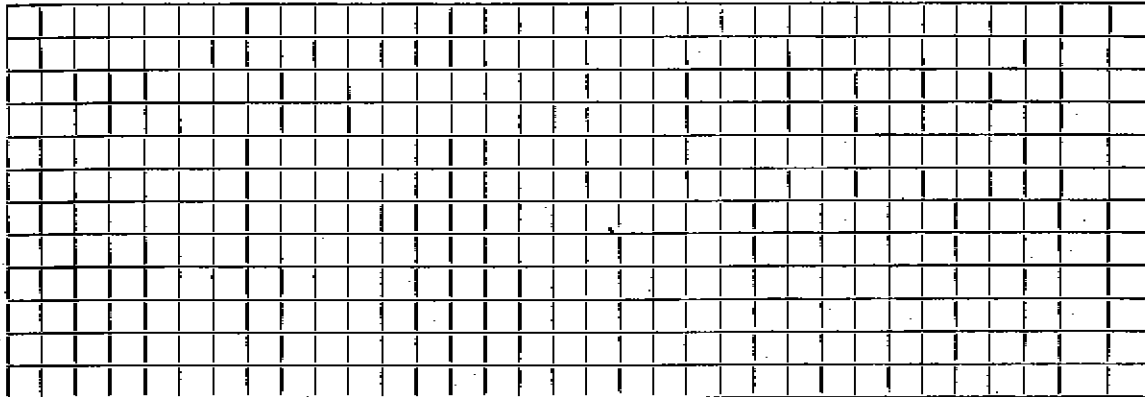

Connection made in..... Street.

Work completed..... 19..

Remarks: