


DATE DEC 1984

TOWN OF LEXINGTON — BOARD OF PUBLIC WORKS

SEWER DIVISION

Sketch of Service Here

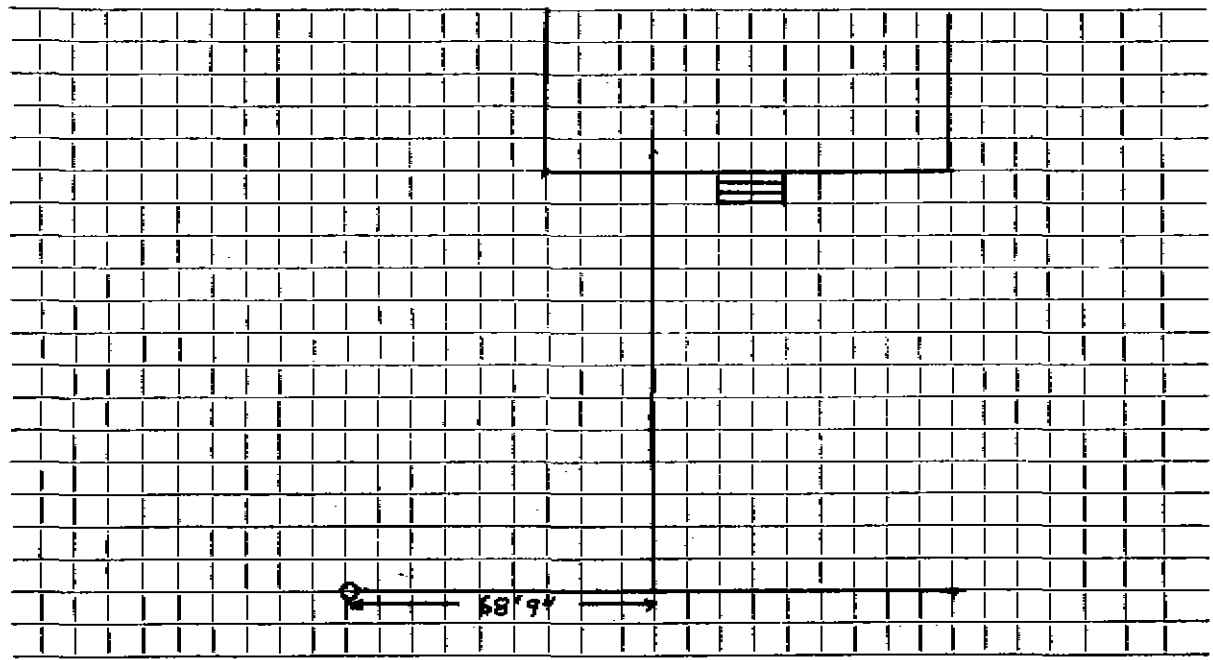

Connection made in WACHUSETT DR. Street. Work completed

Remarks:
.....
.....