

Name

Service No.

Address # 35 WACHUSETT DR.

35 WACHUSETTS DRIVE

Location

Kind of Pipe

AC

Size 6"


Size of Main 8"

Repair—Renewal—New Service

Location

Date	Material	Amount	Total	Date	Amount
12/5/77	313' of 6" AC				
	5' of 4" CI				
	10' of 3" CI				

TOWN OF LEXINGTON — BOARD OF PUBLIC WORKS
SEWER DIVISION

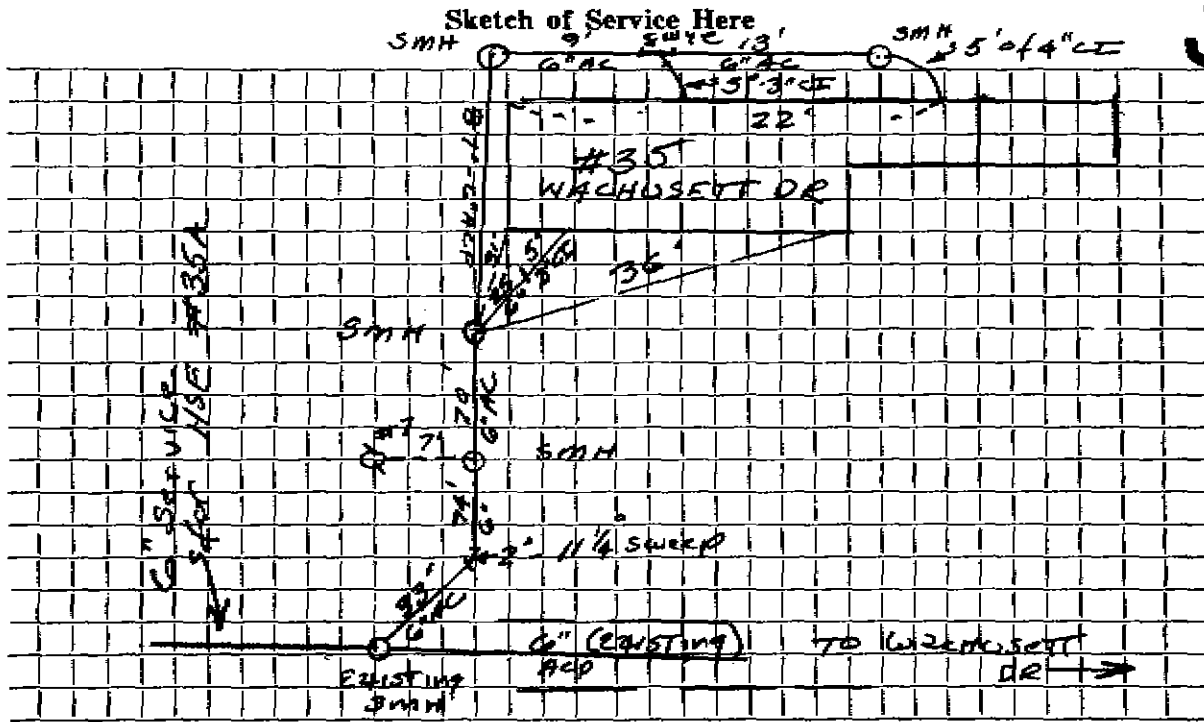

Connection made in WACHUSETT D.R. Street. Work completed

Remarks: See Tr. ~~sheet~~ for sketch of connection in Wachusett

D.P.W.