

Name **Richard Kiley**

Service No. **1**

Address **37 Wachusett Drive**

37 Wachusett Drive

Location

Kind of Pipe

Size **6"**

Size of Main **8"**

~~REWORKED~~ **New Service**

Location **Circle 2-29-60**

Date	Material	Amount	Total	Date	Amount
-60	Labor	62.39		<i>1-4-60</i>	<i>Deposit 200.00</i>
L-60	"	29.64	92.03	<i>4-18-60</i>	<i>Paid 20.41</i>
	10% O.H.	9.20	101.23		<i>220.41</i>
68'	6" Transite pipe @.78		53.04		
1	11 1/2" Transite Elbow		5.10		
1	6" Transite 90° Elbow		5.29		
12	x 3 Patch		12.00		
5	hrs. Town Shovel @6.50		32.50		
3	hrs. Trucking @.75		2.25		
3	hrs. Compressor @5.00		9.00		
			220.41		


Circle 2-29-60 28.41

DATE _____

TOWN OF LEXINGTON — BOARD OF PUBLIC WORKS

SEWER DIVISION

Sketch of Service Here

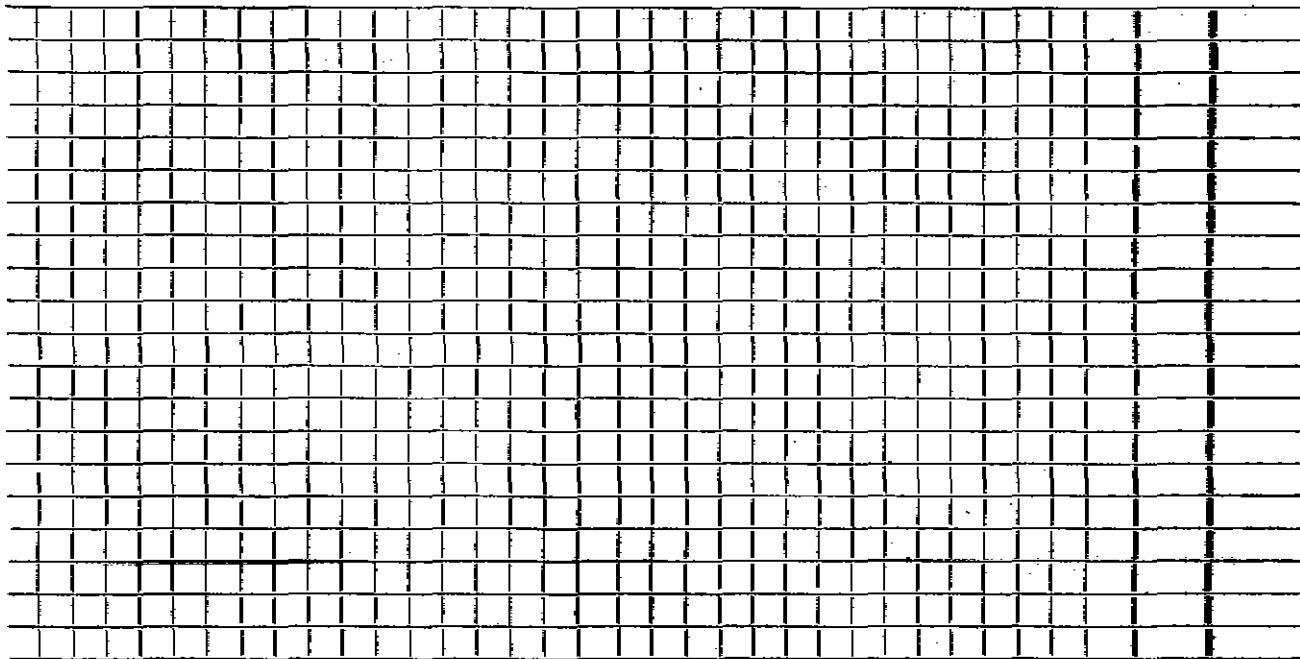

Connection made in Street. Work completed

Remarks:
.....
.....