

Name **C. L. Sturdevant**

Service No. **203**

Address **40 Wachusett Drive**

40 Wachusett Dr, Location
Lexington, Mass.

Kind of Pipe

Size **6"**

Size of Main **8"**

~~REPAIR~~ ~~REPAIR~~ ~~REPAIR~~ **New Service**

com. **12-31-51**

Location

Date	Material	Amount	Total	Date		Amount
12/13/51	Labor	54 41		12-5-51	Deposited	150 00
	10% overhead	5 44	59 85	12-31-51	Refunded	(31 95)
	64' - 6" sewer pipe @ .342		21 88			118 95
	1 - 6" elbow		1 88			
	joint compound		3 84			
	6 hrs. town shovel @ 5.00		30 00			
	2 hrs. trucking		1 50			
0-21-76	Repair		118 95			
	1 6" 90° clay Elbow					
				1-31-73	Wastkins to Pampers	
				2-1-73	Books, maps & paper	
				11-20-74	Roofs	
	Labor					

TOWN OF LEXINGTON—DEPT. OF PUBLIC WORKS
SEWER DIVISION

DATE

NO.


The undersigned applies for the construction of a particular sewer connecting No.
Street and hereby agrees to comply with the Rules and Regulations governing the construction and use of Particular
Sewers, as now or at any future time established by the Board of Selectmen.

Am't of estimate \$.....

Am't Paid \$.....

..... Owner

Sketch of Service Here

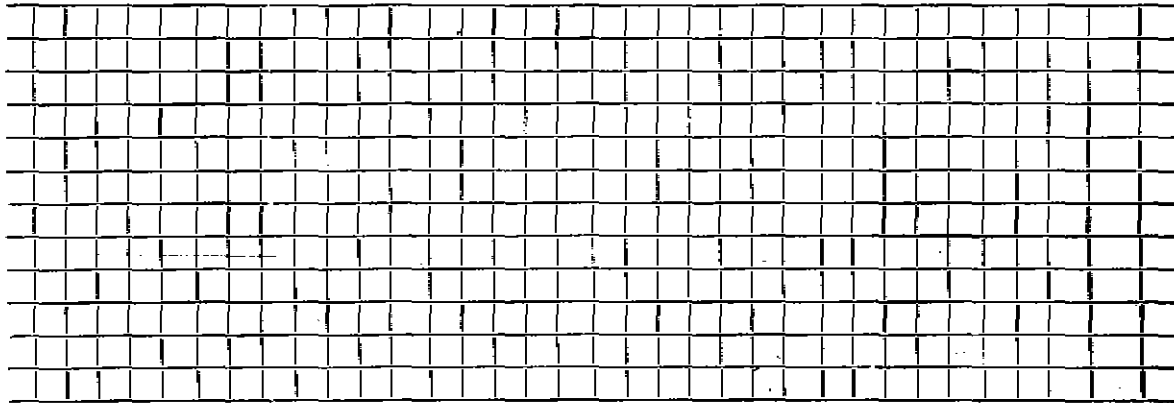

Connection made in Street.

Work completed 19..

Remarks: