

Name Philip J. Darlington

Service No. 166

Address 45 Wachusett Drive

Lexington, Mass. ^{45 Wachusett Dr.} Location

Kind of Pipe

Size 6"

Size of Main 8"

~~Repair~~ ~~Renewal~~ New Service

com. 12-31-51

Location

Date	Material	Amount	Total	Date	Amount
2/10/51	Labor	62 57		10-18-51	Deposited 175 -
	10% overhead	6 26	68 83	12-31-51	Refunded (59 64)
	46' -6" sewer pipe @ .342		15 73		115 36
	1 - 6" -1/8 bend		1 54		
	joint compound		2 76		
	5 hrs. town shovel @ 5.00		25 00		
	2 hrs. trucking		1 50		
			115 36		
	Labor				

TOWN OF LEXINGTON—DEPT. OF PUBLIC WORKS

SEWER DIVISION

DATE

NO.


The undersigned applies for the construction of a particular sewer connecting No.
Street and hereby agrees to comply with the Rules and Regulations governing the construction and use of Particular
Sewers, as now or at any future time established by the Board of Selectmen.

Am't of estimate \$.....

Am't Paid \$.....

..... Owner

Sketch of Service Here

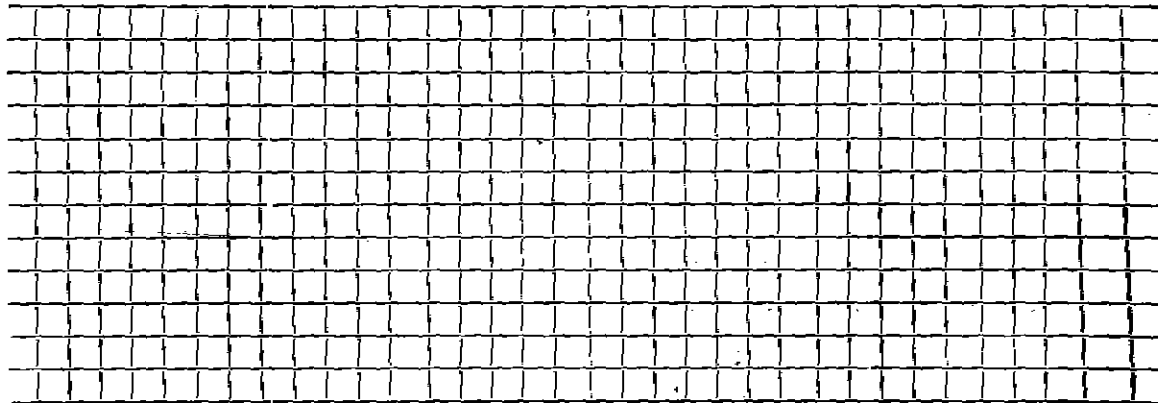

Connection made in Street. Work completed 19..

Remarks: