




DATE 12/1/83

TOWN OF LEXINGTON — BOARD OF PUBLIC WORKS  
SEWER DIVISION

Sketch of Service Here

7

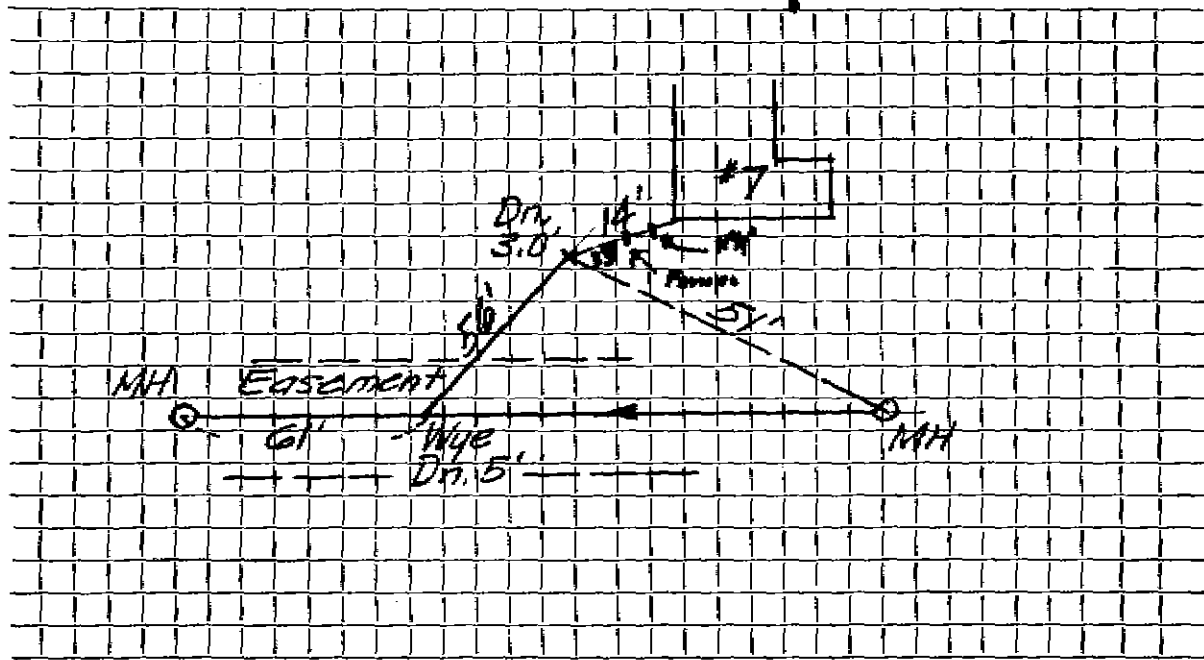

Connection made in Easement Street. Work completed .....

Remarks: .....  
.....  
.....