


TOWN OF LEXINGTON — BOARD OF PUBLIC WORKS

SEWER DIVISION

Sketch of Service Here **6**

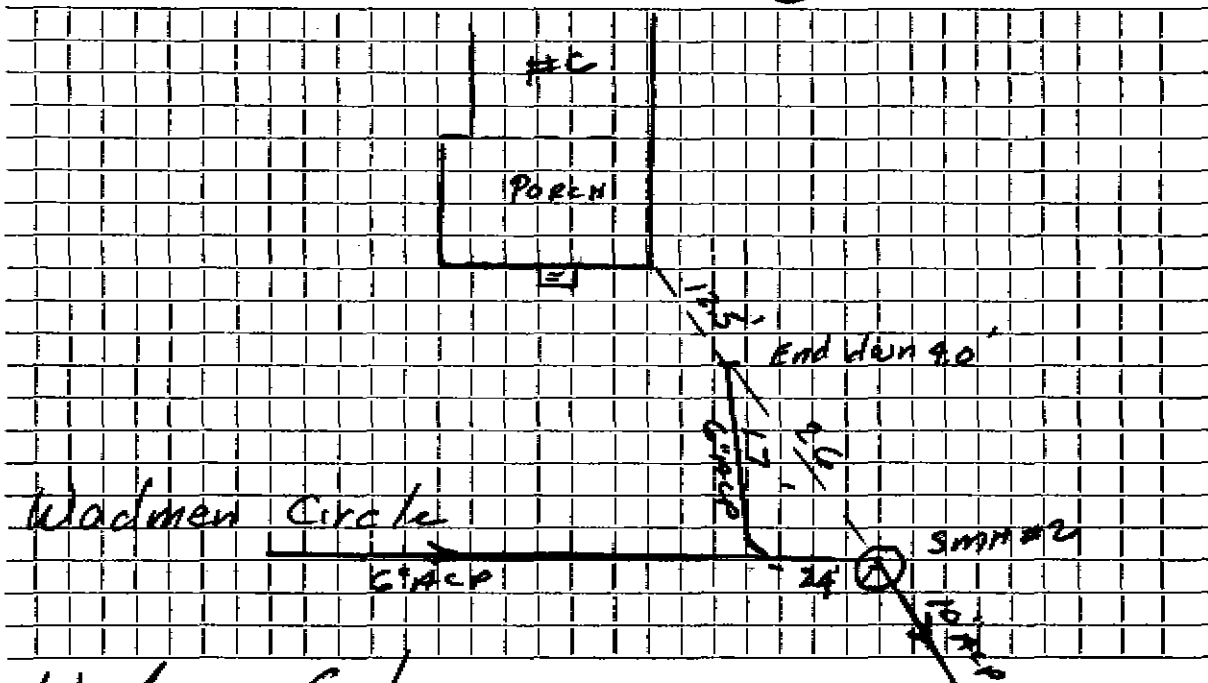

Connection made in Wadman Circle Street. Work completed

Remarks: 3/4" Water Service (copper) above end of Pipe