

Service No. 78

Address 274 Wallis Court

274 Wallis Court

Location 274 Wallis Court

Kind of Pipe

Size 6"

Size of Main 6"

Repair—Renewal—New Service

Location

Date	Material	Amount	Total	Date	Amount
1929					

Labor

**TOWN OF LEXINGTON — BOARD OF PUBLIC WORKS**  
**SEWER DIVISION**

DATE \_\_\_\_\_

NO. \_\_\_\_\_


The undersigned applies for the construction of a particular sewer connecting No. 244 Wallis Court Street and hereby agrees to comply with the Rules and Regulations governing the construction and use of Particular Sewers, as now or at any future time established by the Board of Selectmen.

Am't. of Estimate \$ \_\_\_\_\_

Am't. Paid \$ \_\_\_\_\_

\_\_\_\_\_ Owner

Sketch of Service Here

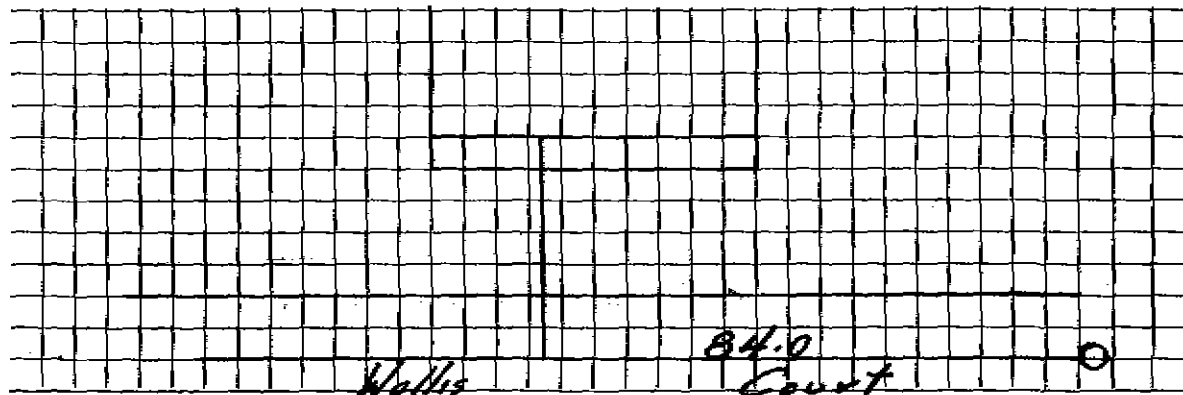

Connection made in \_\_\_\_\_ Street.

Work completed \_\_\_\_\_ 19

Remarks: