

Service No. 4534

Address **3 Wallis Court**
3 Wallis Court Location **3 Wallis Court**

Kind of Pipe _____ Size **6"** Size of Main **6"**

Repair—Renewal—New Service _____ Location _____

Date	Material	Amount	Total	Date	Amount
1929					
				3.2.30	Route
	Labor				

TOWN OF LEXINGTON—BOARD OF PUBLIC WORKS
SEWER DIVISION

DATE _____

NO. _____


The undersigned applies for the construction of a particular sewer connecting No. 3 Wallis Court Street and hereby agrees to comply with the Rules and Regulations governing the construction and use of Particular Sewers, as now or at any future time established by the Board of Selectmen.

Am't. of Estimate \$ _____

Am't. Paid \$ _____

Owner

Sketch of Service Here

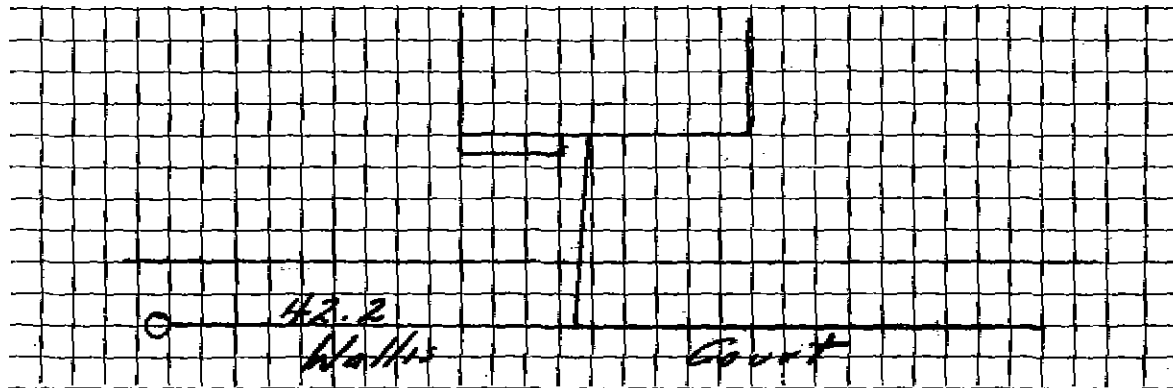

Connection made in _____ Street.

Work completed _____ 19

Remarks: