


DATE July 21, 1976

TOWN OF LEXINGTON — BOARD OF PUBLIC WORKS
SEWER DIVISION

Sketch of Service Here **10**

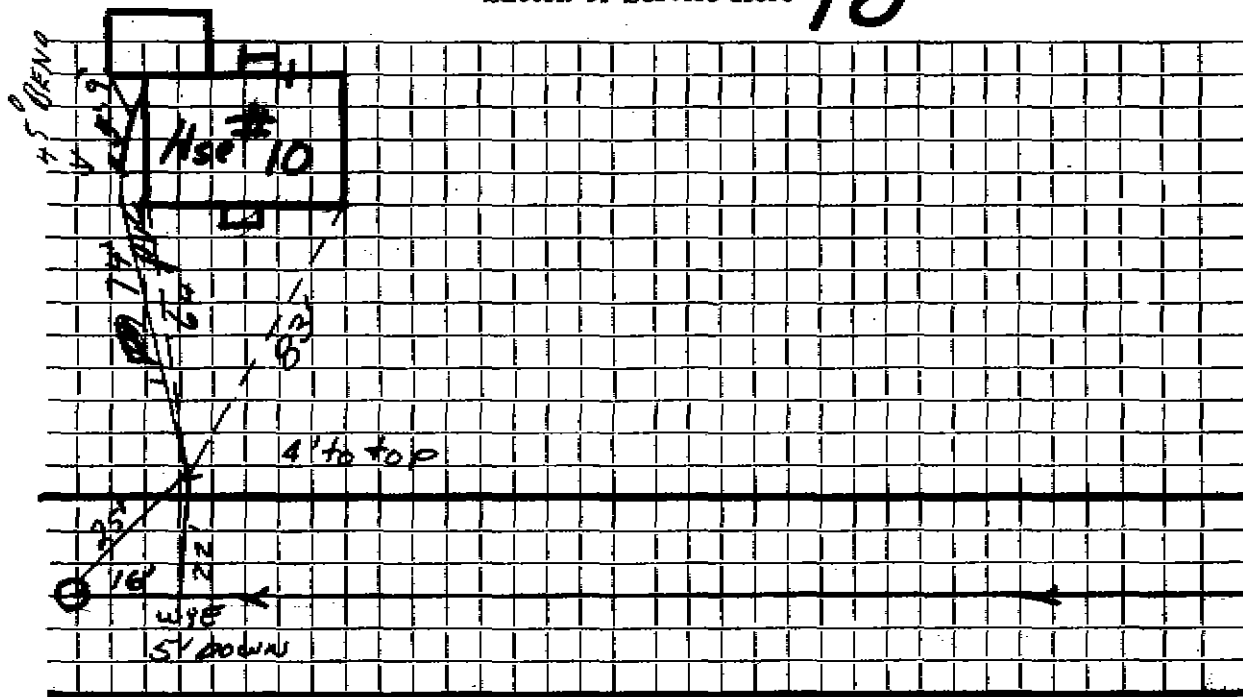

Connection made in WALNUT ST. Street. Work completed

Remarks: 7.9 ft. P.V.C.