

Estimate No. 2.

Service No. 39

A. Valenzano

4 Walnut Street

Location

Line of Pipe A.C.

Size 6"

New Service Substitution \$260

Size of Main 6"

Location FEB 22 1982

Date	Material	Amount	Total	Date	Amount
7/16/76	26' 6" A.C. @ \$12.00	\$ 312.00			
10/1/81	100' P.V.C. pipe 6"				
12/4/81	1 4" G.I.				
	1 4" P.V.C. Bend				
	1 Clean out				
	1 4" 1/8 Bend				
	1 4" 1/16 Bend				

7/16/76 26' 6" A.C. @ \$12.00

10/1/81 100' P.V.C. pipe 6"

12/4/81 1 4" G.I.

1 4" P.V.C. Bend

1 Clean out

1 4" 1/8 Bend

1 4" 1/16 Bend


**Remarks:**

100

Work completed

12

..... Street. Work completed.

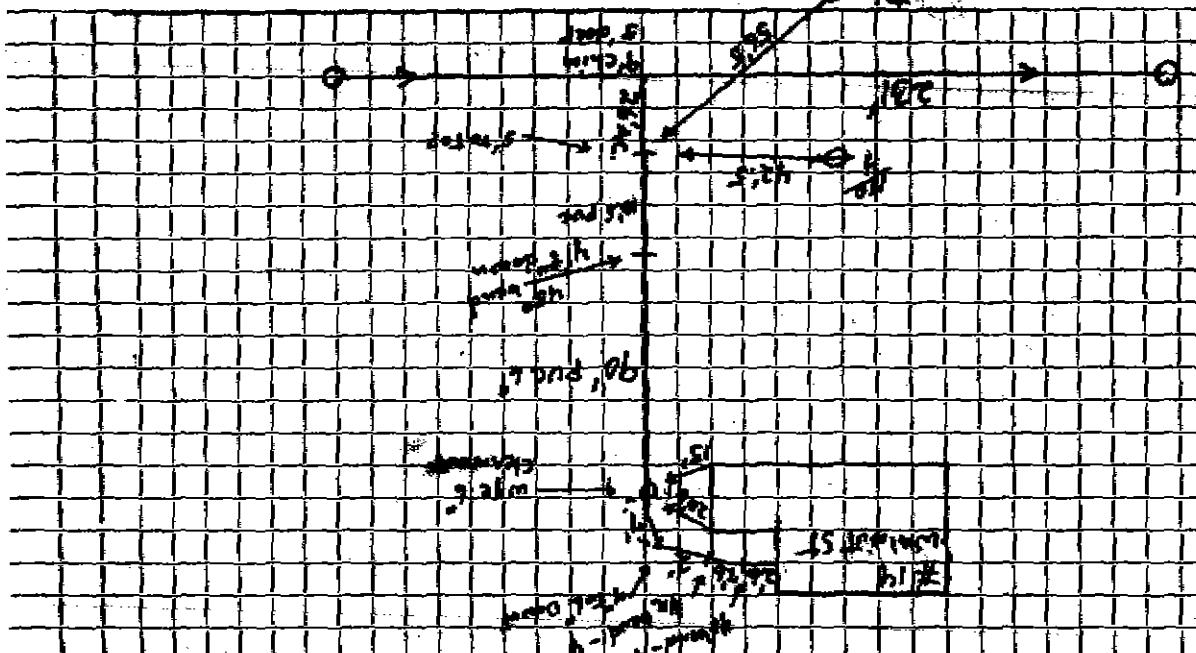

Sketch of Service Here / 4

## **SEWER DIVISION**

TOWN OF LEXINGTON — BOARD OF PUBLIC WORKS

-31-