

Name Murray T. Potter

Service No. 76

1976

Address # 19 WALNUT ST.

19 Walnut Street

JUN 20 1977

Location

Kind of Pipe AC

Size 6"

Size of Main 8"

~~REPAIR/REPLACE~~ New Service Eagle #2992


Location

Date	Material	Amount	Total	Date	Amount
Jul 19 76	11'-6" ACC @ \$10	110		9/14/76	Deposit 110.00

DATE July 19, 1976

TOWN OF LEXINGTON — BOARD OF PUBLIC WORKS
SEWER DIVISION

Sketch of Service Here **19**

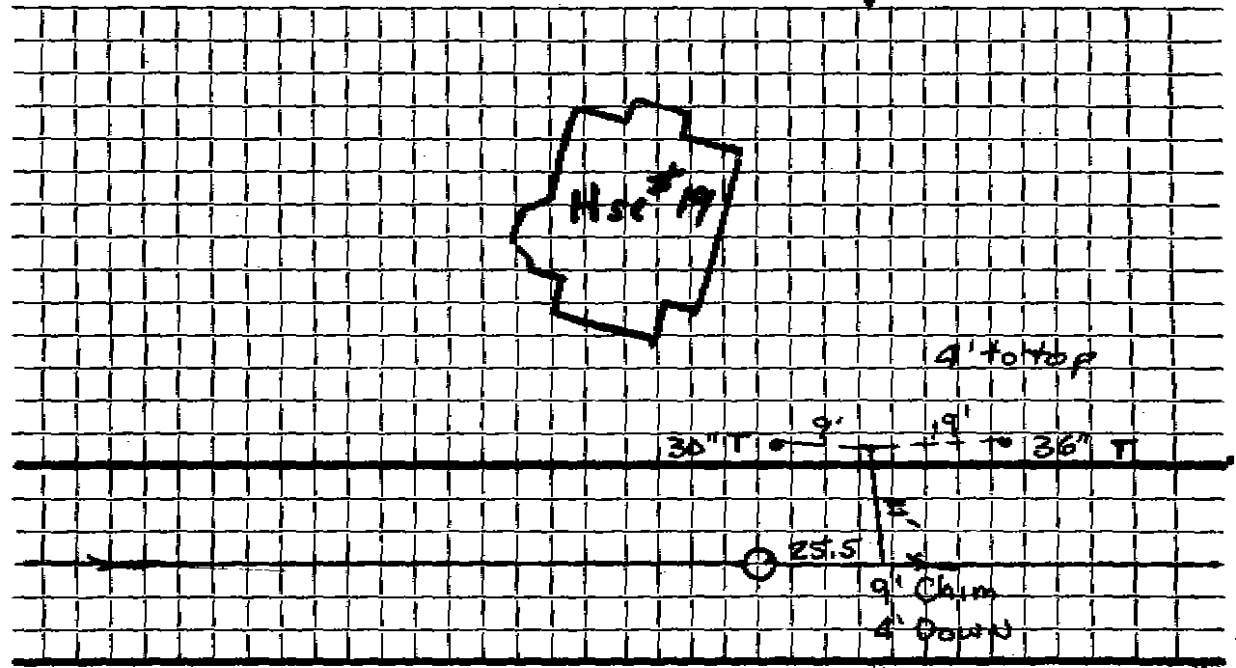

Connection made in WALNUT Street. Work completed

Remarks: