




DATE 8/5/08

TOWN OF LEXINGTON — BOARD OF PUBLIC WORKS  
SEWER DIVISION

Sketch of Service Here

Will have pump for  
bsmt  
B.R.

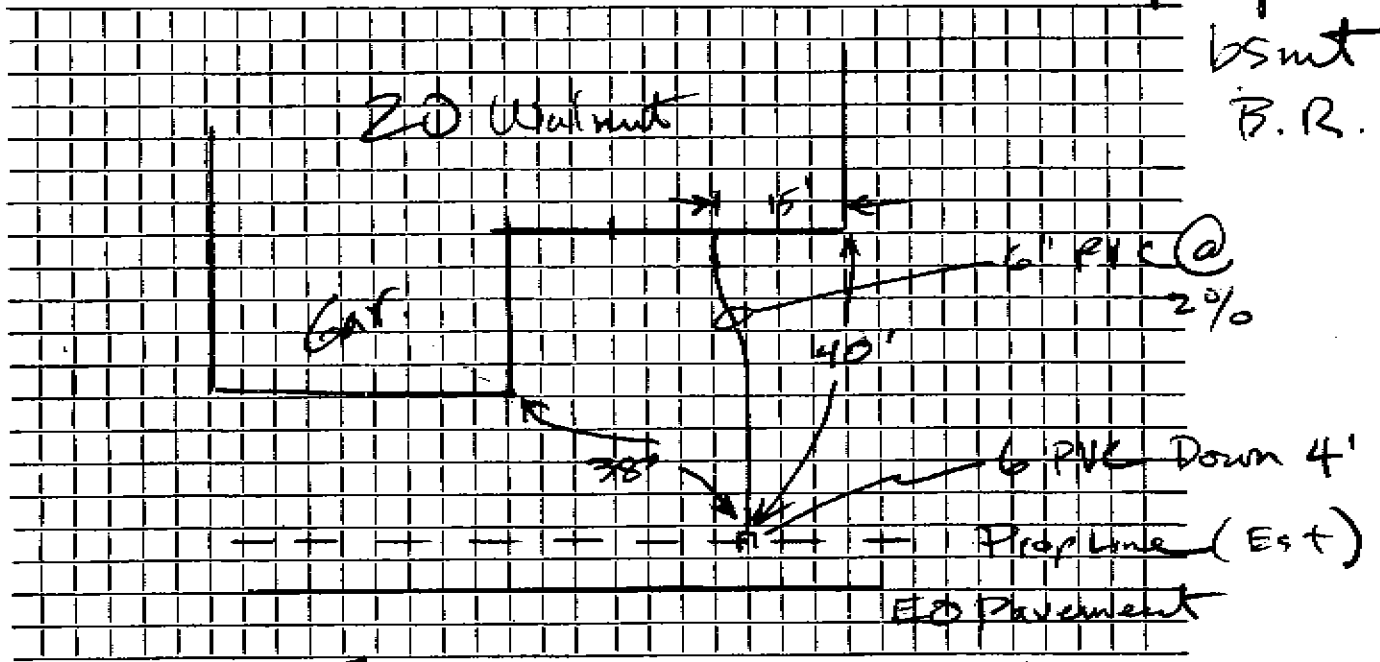

Connection made in Walnut Street. Work completed 8/5/08

Remarks: Mr. Flanagan  
Eng. Div.