


DATE 5/20/76

TOWN OF LEXINGTON — BOARD OF PUBLIC WORKS SEWER DIVISION

21 Sketch of Service Here

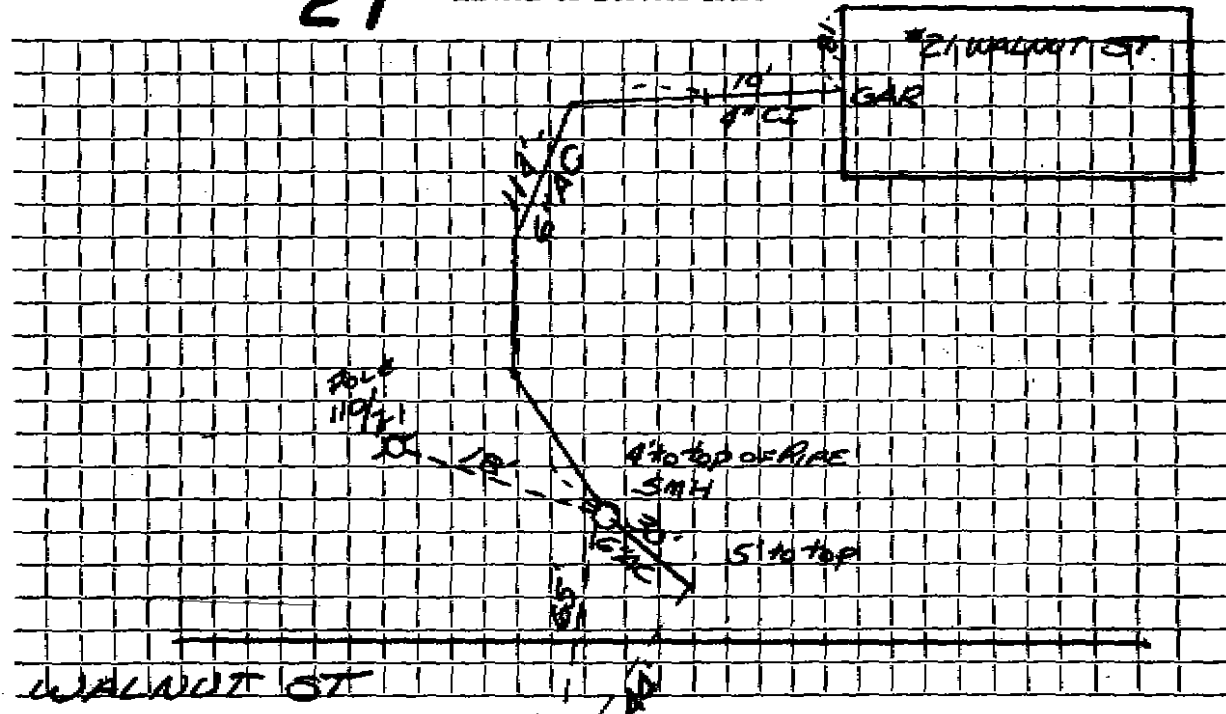

Connection made in Street. Work completed

Remarks:

FILE 247

DANE EGAN by E.D.L.