

Name

Service No. 2752

Address

230 Waltham ST

Location

LOT 220

Kind of Pipe

PVC + A.C.

Size

Size of Main

Repair—Renewal—New Service

J. McLaughlin

Location

Date

Material

Amount

Total

Date

Amount

Date	Material	Amount	Total	Date	Amount
4/9/08	5' Sch 40 - 4" PVC				
	63' 6" PVC				
	2' 0" 6" PVC				
	1 4x6 Ferrule				
	1 6" - 22 1/2° bend				
	1 6" - PVC x A.C. Ferrule				

1957

EXIST 1 1/2" Elbow


6" A.C. Pipe

Chimney	10' 6" - VC Pipe	3			
	1 6" Elbow				

DATE \_\_\_\_\_

**TOWN OF LEXINGTON — BOARD OF PUBLIC WORKS**  
**SEWER DIVISION**

Sketch of Service Here

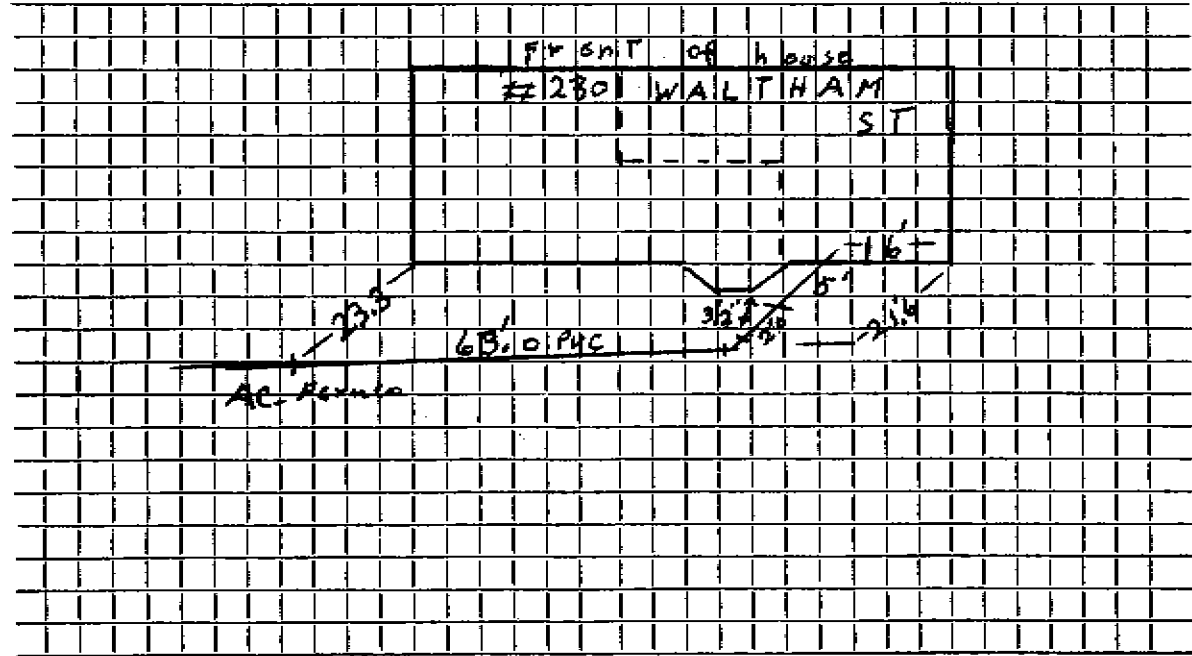

Connection made in ..... Street. Work completed 4/9/08 J. McLaughlin

Remarks: .....  
.....  
.....