

Name

Service No.

Address

25 Walnut ST

Location

PG-A LOT 1A-B

Kind of Pipe PVC

Size

Size of Main

Repair—Renewal—New Service Arlex OIL Corp


Location

Date	Material	Amount	Total	Date	Amount
5/9/11	8' 4" Sch 40 - 3' cover @ house				
	1 4x6 Fernco				
	6" Cleanout				
	54' 6" PVC				
	1 6" wye Cleanout				
	1 1 1/2" sweep				
	1 22° bend				
	45' 6" 6" PVC				
	2 1 1/2" heads				
EXIST Stub -	13' 6" AC				
	1 PVC x AC, Fernco Dish 5.0"				

DATE \_\_\_\_\_

TOWN OF LEXINGTON — BOARD OF PUBLIC WORKS  
SEWER DIVISION

Sketch of Service Here

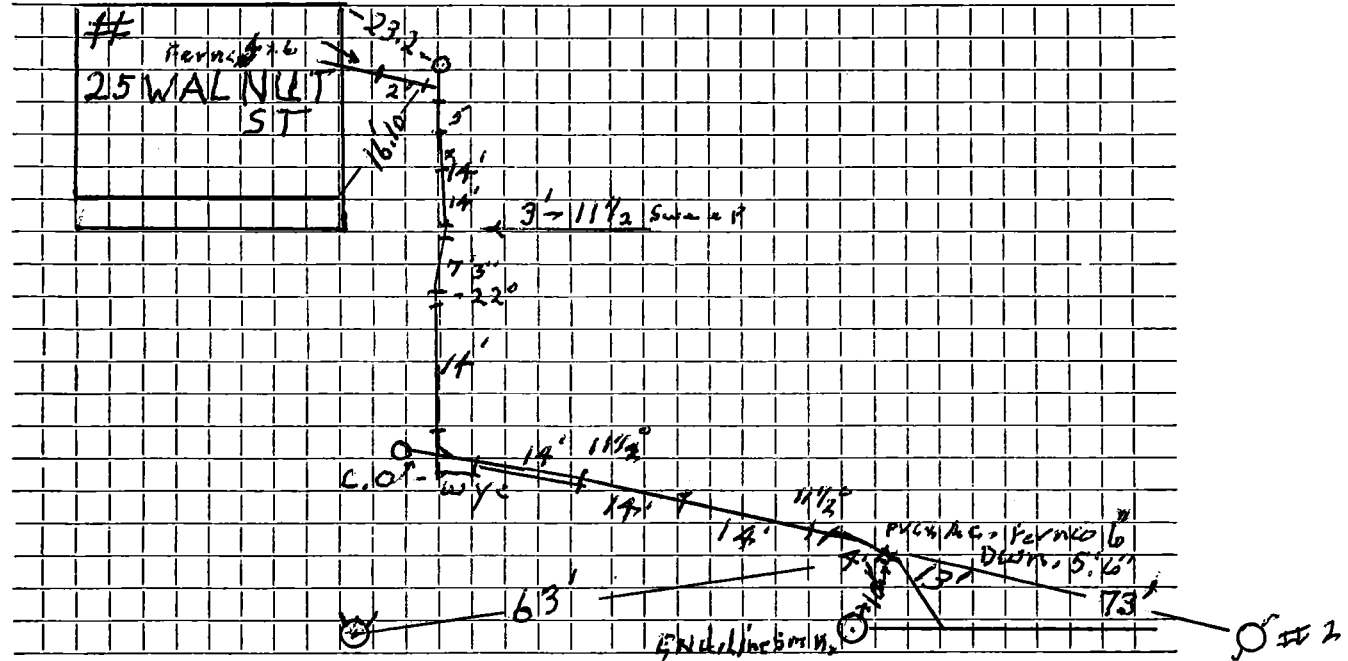

Connection made in ..... Street. Work completed .....

Remarks: .....

.....  
.....