


DATE _____

TOWN OF LEXINGTON — BOARD OF PUBLIC WORKS

SEWER DIVISION

Sketch of Service Here

35

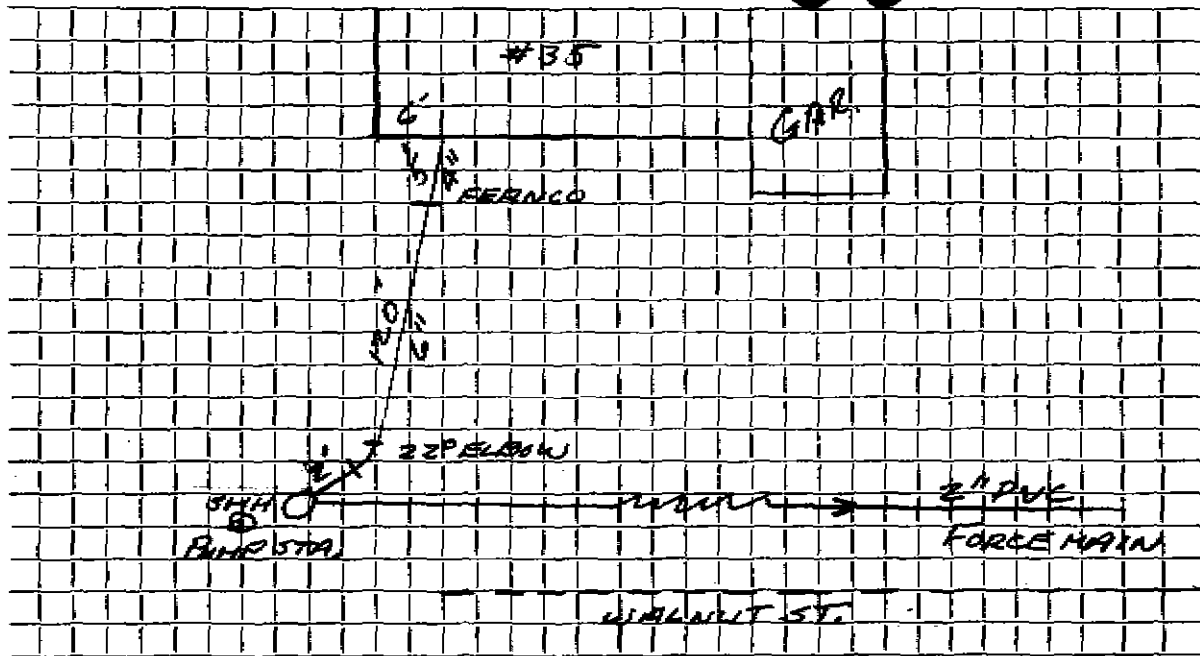

Connection made in WALNUT ST. Street. Work completed

Remarks: 2" FORCE MAIN PUMPS TO GRAVITY FLOW @ WALNUT ST.