


DATE _____

TOWN OF LEXINGTON — BOARD OF PUBLIC WORKS

SEWER DIVISION

Sketch of Service Here **37**

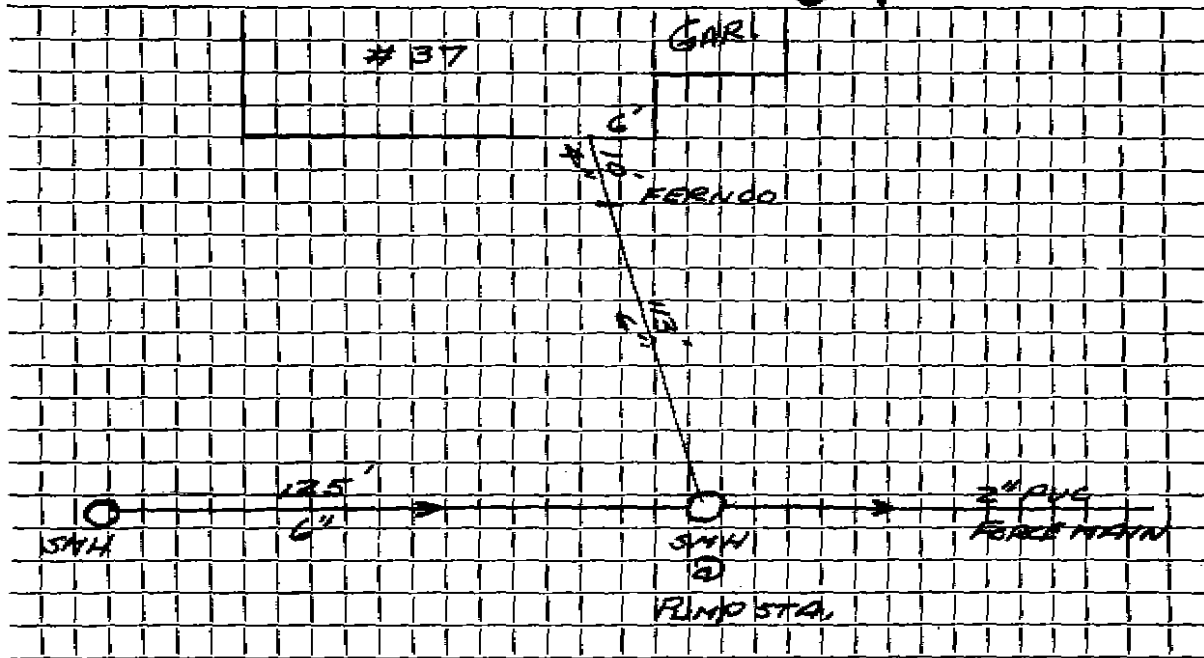

Connection made in SMH Street. Work completed

Remarks: SMH @ PUMP STA., PUMPS TO GRAVITY ON WALNUT ST.