

Name Robert Phelan

Service No.

Address 41 WALNUT ST LOT 14 F1

41 WALNUT STREET

Location

Kind of Pipe PVC

Size 4" x 8"

Size of Main 6"

Repair—Renewal—New Service

Redmond #4619

Location


Date	Material	Amount	Total	Date	Amount
11/16/87	62 LF 6" PVC				
	10 LF 4" PVC				
	4" X 6" FERRO				

DATE _____

TOWN OF LEXINGTON — BOARD OF PUBLIC WORKS

SEWER DIVISION

Sketch of Service Here **41**

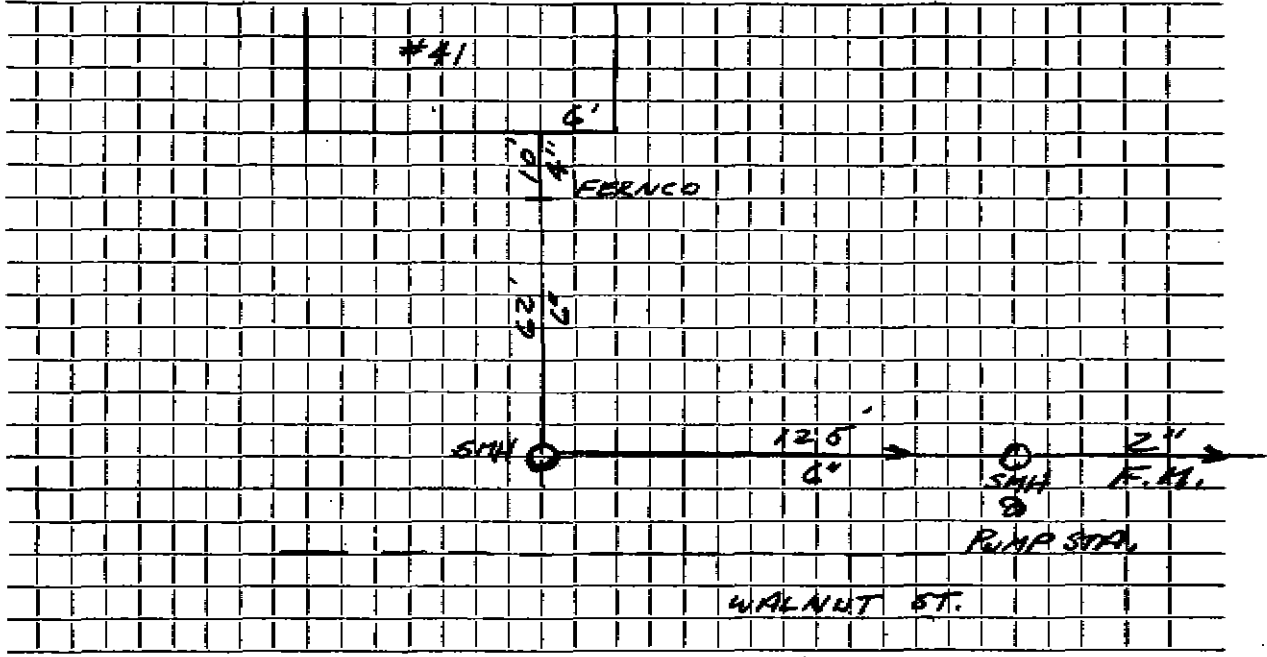

Connection made in SMH Street. Work completed

Remarks: SMH FLOWS TO PUMP STA.