


DATE 4/3/2018

TOWN OF LEXINGTON — BOARD OF PUBLIC WORKS
SEWER DIVISION

Sketch of Service Here

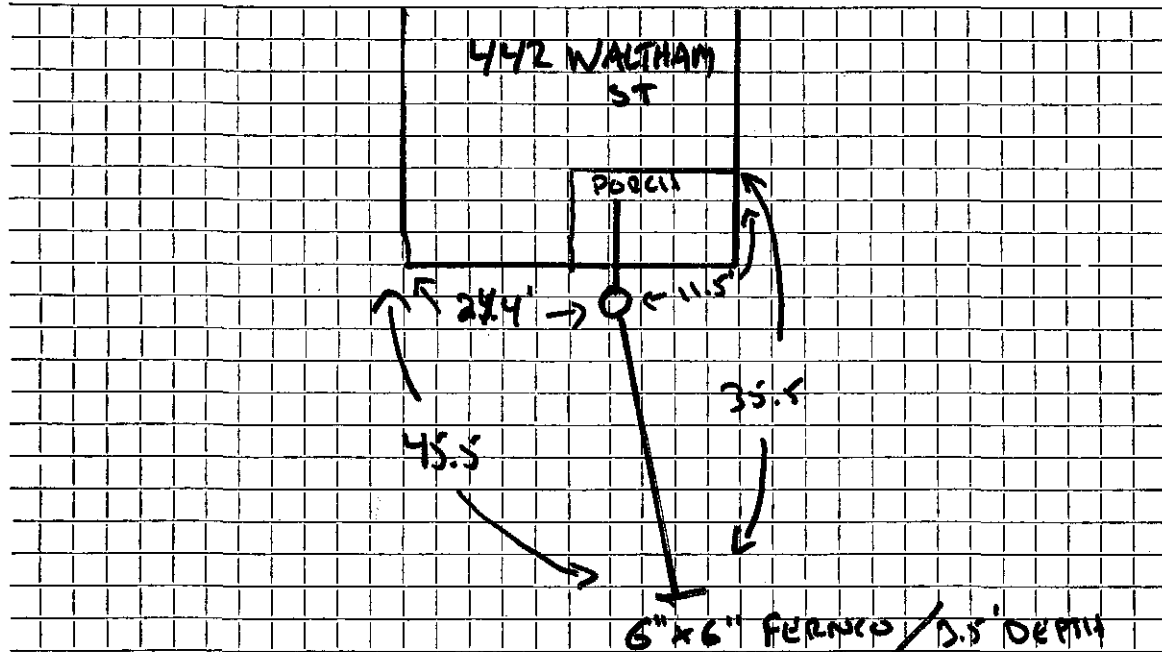

Connection made in WALTHAM Street. Work completed McLAUGHLIN

Remarks: