

Name

Service No.

Address 100 Waltham St

Location

Kind of Pipe

Size 6"

Size of Main 8"

Repair - Renewal - New Service

Location

Date	Material	Amount	Total	Date	Amount
Nov 2, 1988				1988	
53'	6" PVC				
8'	4" PVC				
	4x6 PVC to PVC Hinges				
	6x6 PVC to PVC Ferrule				


Repair made in street

DATE \_\_\_\_\_

TOWN OF LEXINGTON — BOARD OF PUBLIC WORKS

SEWER DIVISION

Sketch of Service Here

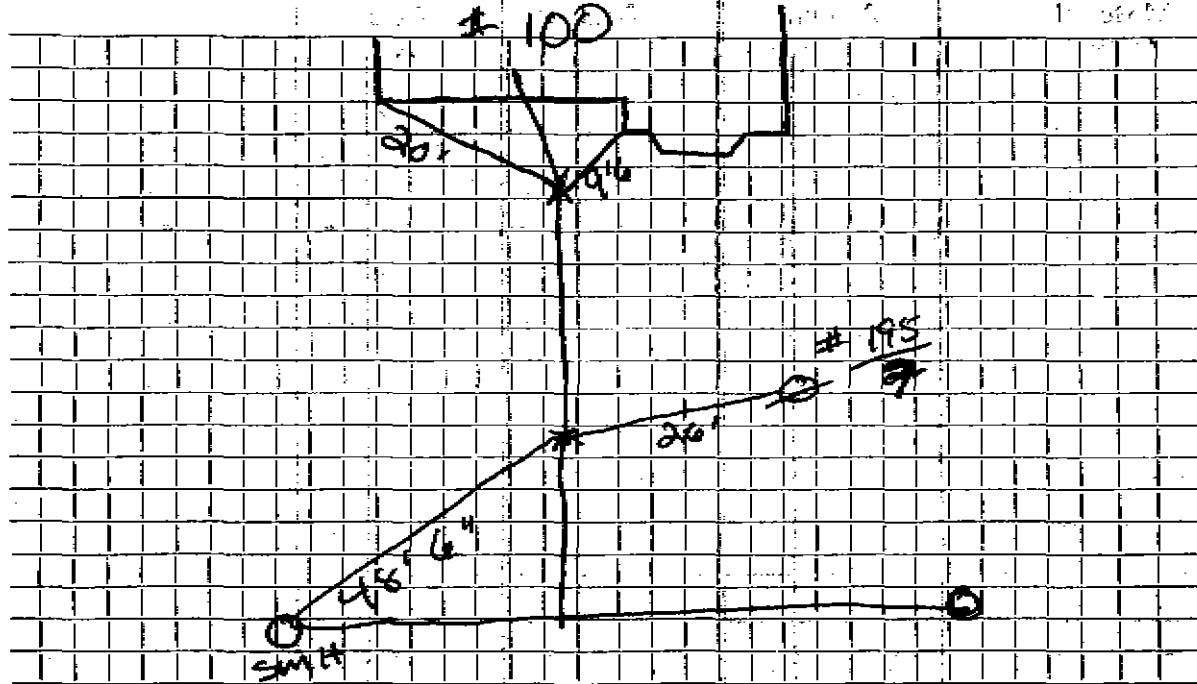

Connection made in \_\_\_\_\_ Street. Work completed \_\_\_\_\_

Remarks: SERVICE to VACANT lot put in 11-2-98