


DATE _____

TOWN OF LEXINGTON — BOARD OF PUBLIC WORKS
SEWER DIVISION

Sketch of Service Here **1012**

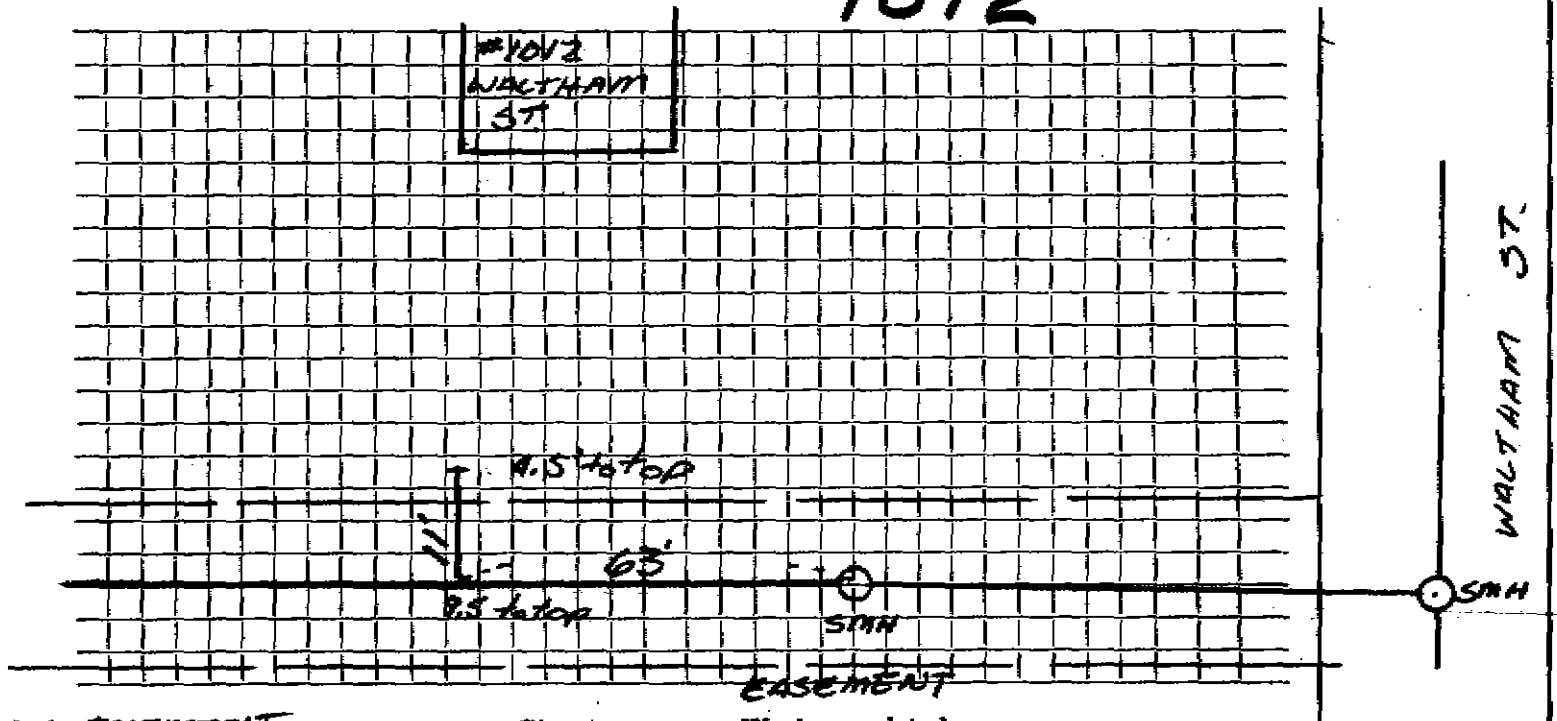

Connection made in EASEMENT..... Street.
WALTHAM ST TO CONCORD AVE

Work completed

Remarks:

.....

.....