


DATE _____

TOWN OF LEXINGTON — BOARD OF PUBLIC WORKS
SEWER DIVISION

Sketch of Service Here

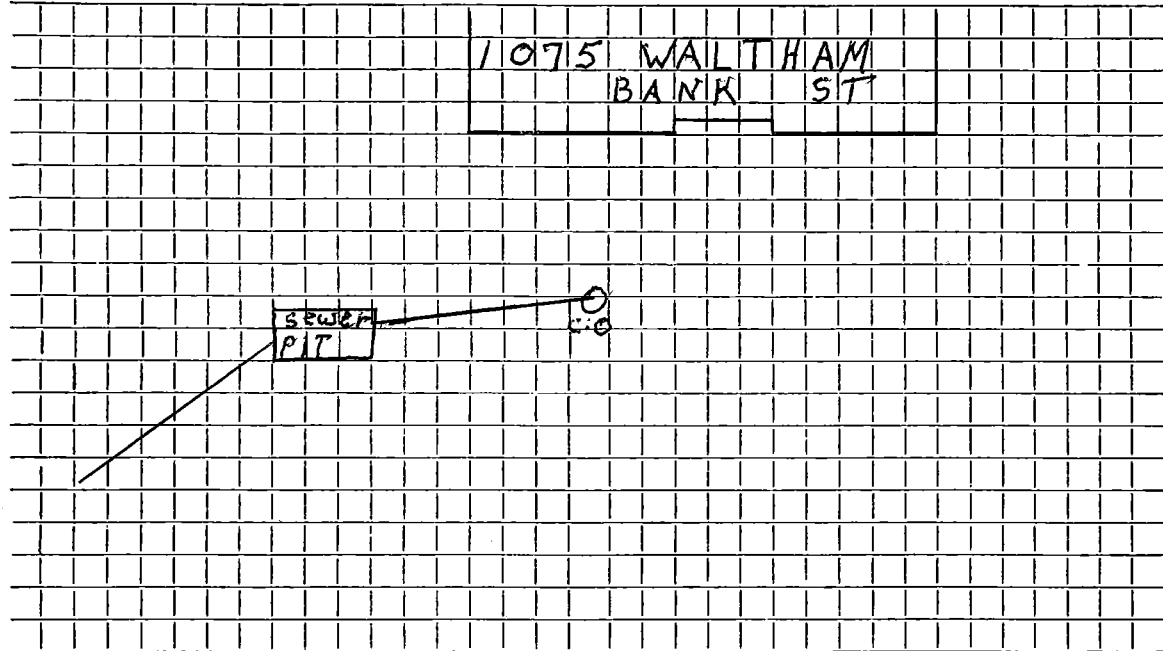

Connection made in WALTHAM Street. Work completed Permits: 10/15/07
Remarks: SEWER SERVICE GOES TO WALTHAM SEWER

.....
.....