


DATE 6/18/92

TOWN OF LEXINGTON — BOARD OF PUBLIC WORKS SEWER DIVISION

Sketch of Service Here **113**

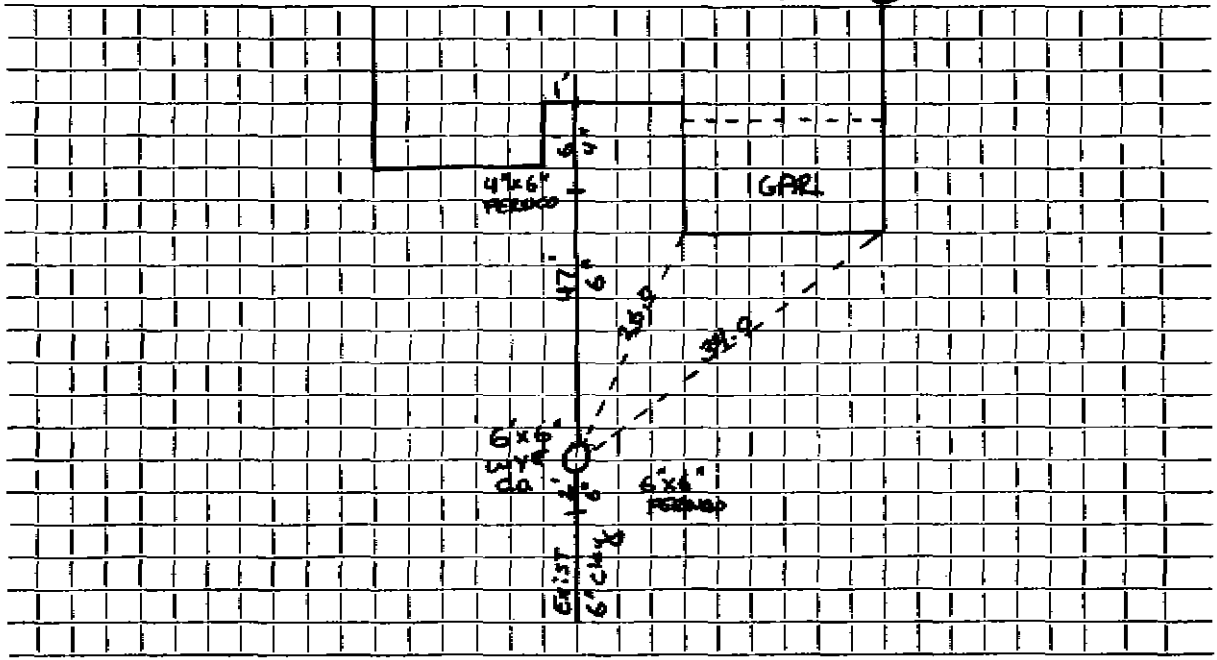

Connection made in Street. Work completed

Remarks: INSTALLED BY J.M. LAUGHLIN

INSPECTED BY CRG

Original Service 1929