




DATE \_\_\_\_\_

TOWN OF LEXINGTON — BOARD OF PUBLIC WORKS

SEWER DIVISION

Sketch of Service Here

130

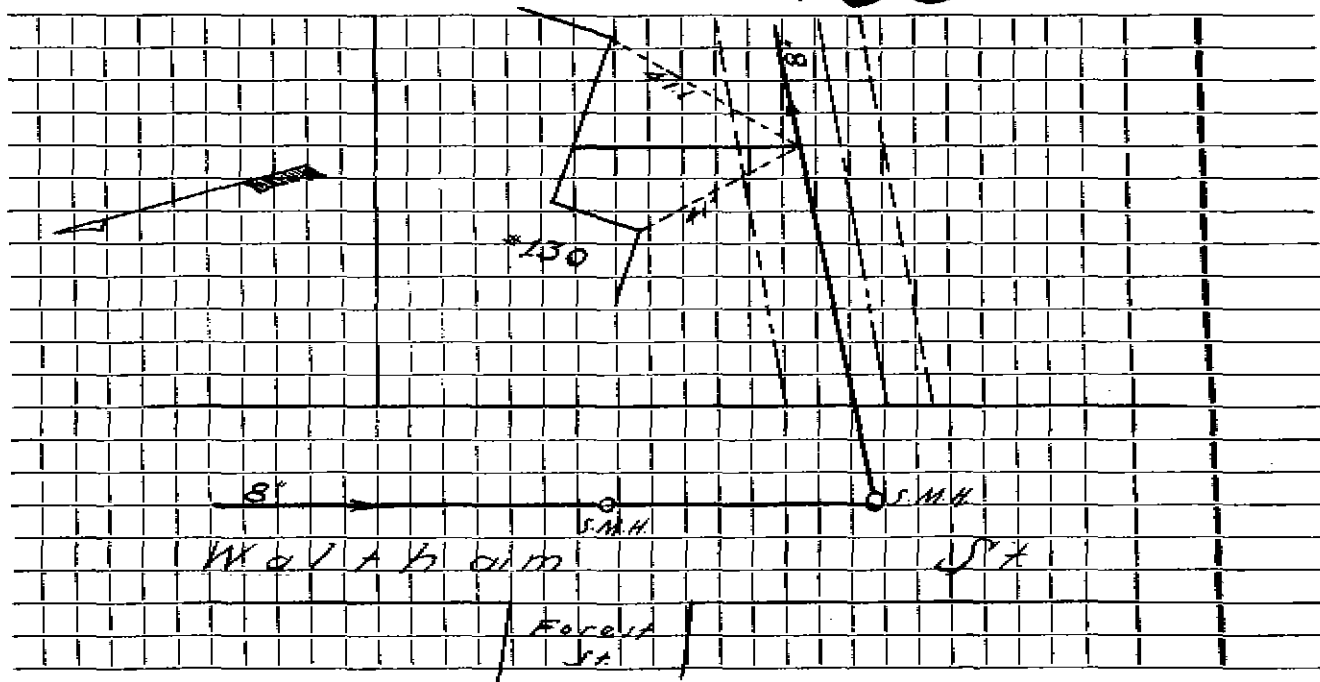

Connection made in \_\_\_\_\_ Street. Work completed \_\_\_\_\_

Remarks: Original Service 12-3-53 (6'-6 Sewer Pipe)